



AMBER RIDGE CONDOMINIUMS

SECTION 34, TOWNSHIP 24 NORTH, RANGE 6 EAST, W.M.


CITY OF ISSAQUAH, KING COUNTY, WASHINGTON 102-76
CONDO.

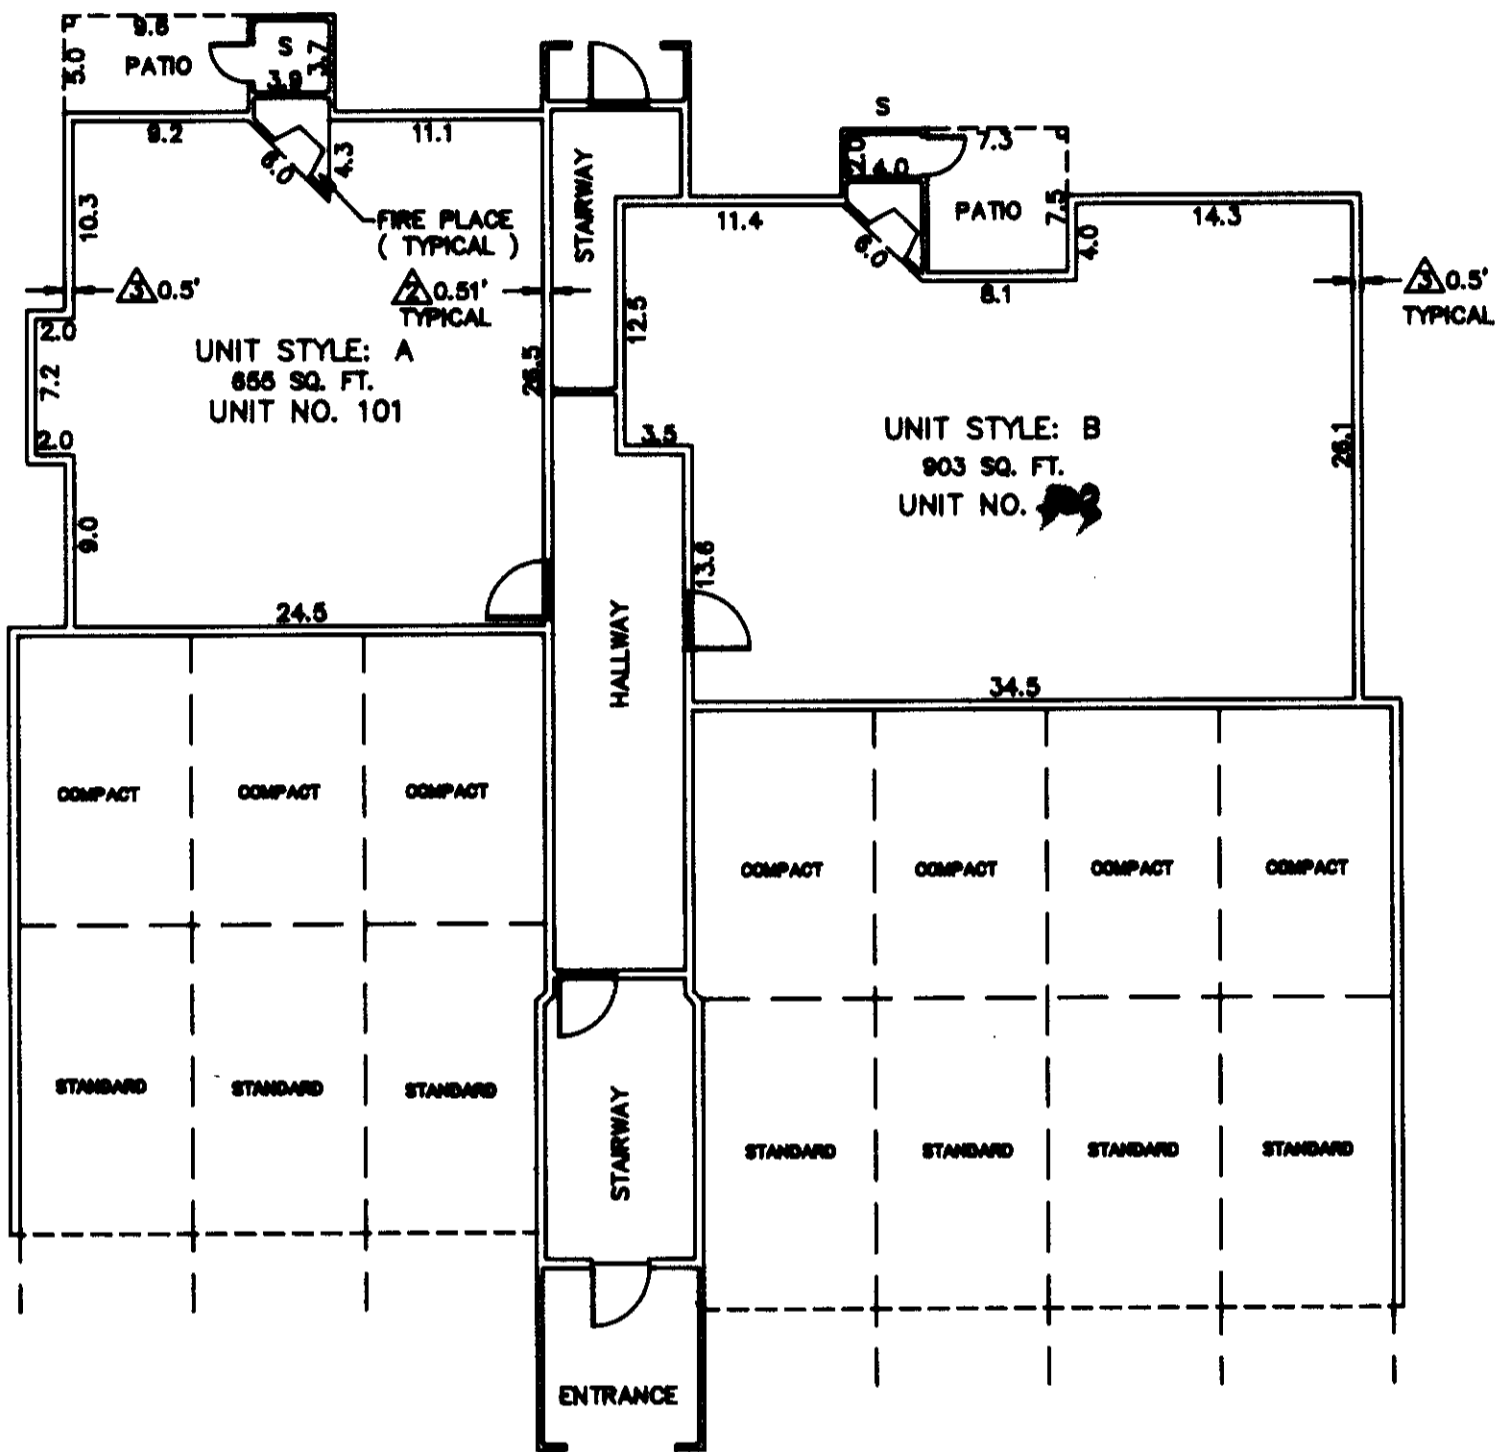

FIRST FLOOR PLAN
TYPICAL ALL BUILDINGS
SCALE 1" = 40'

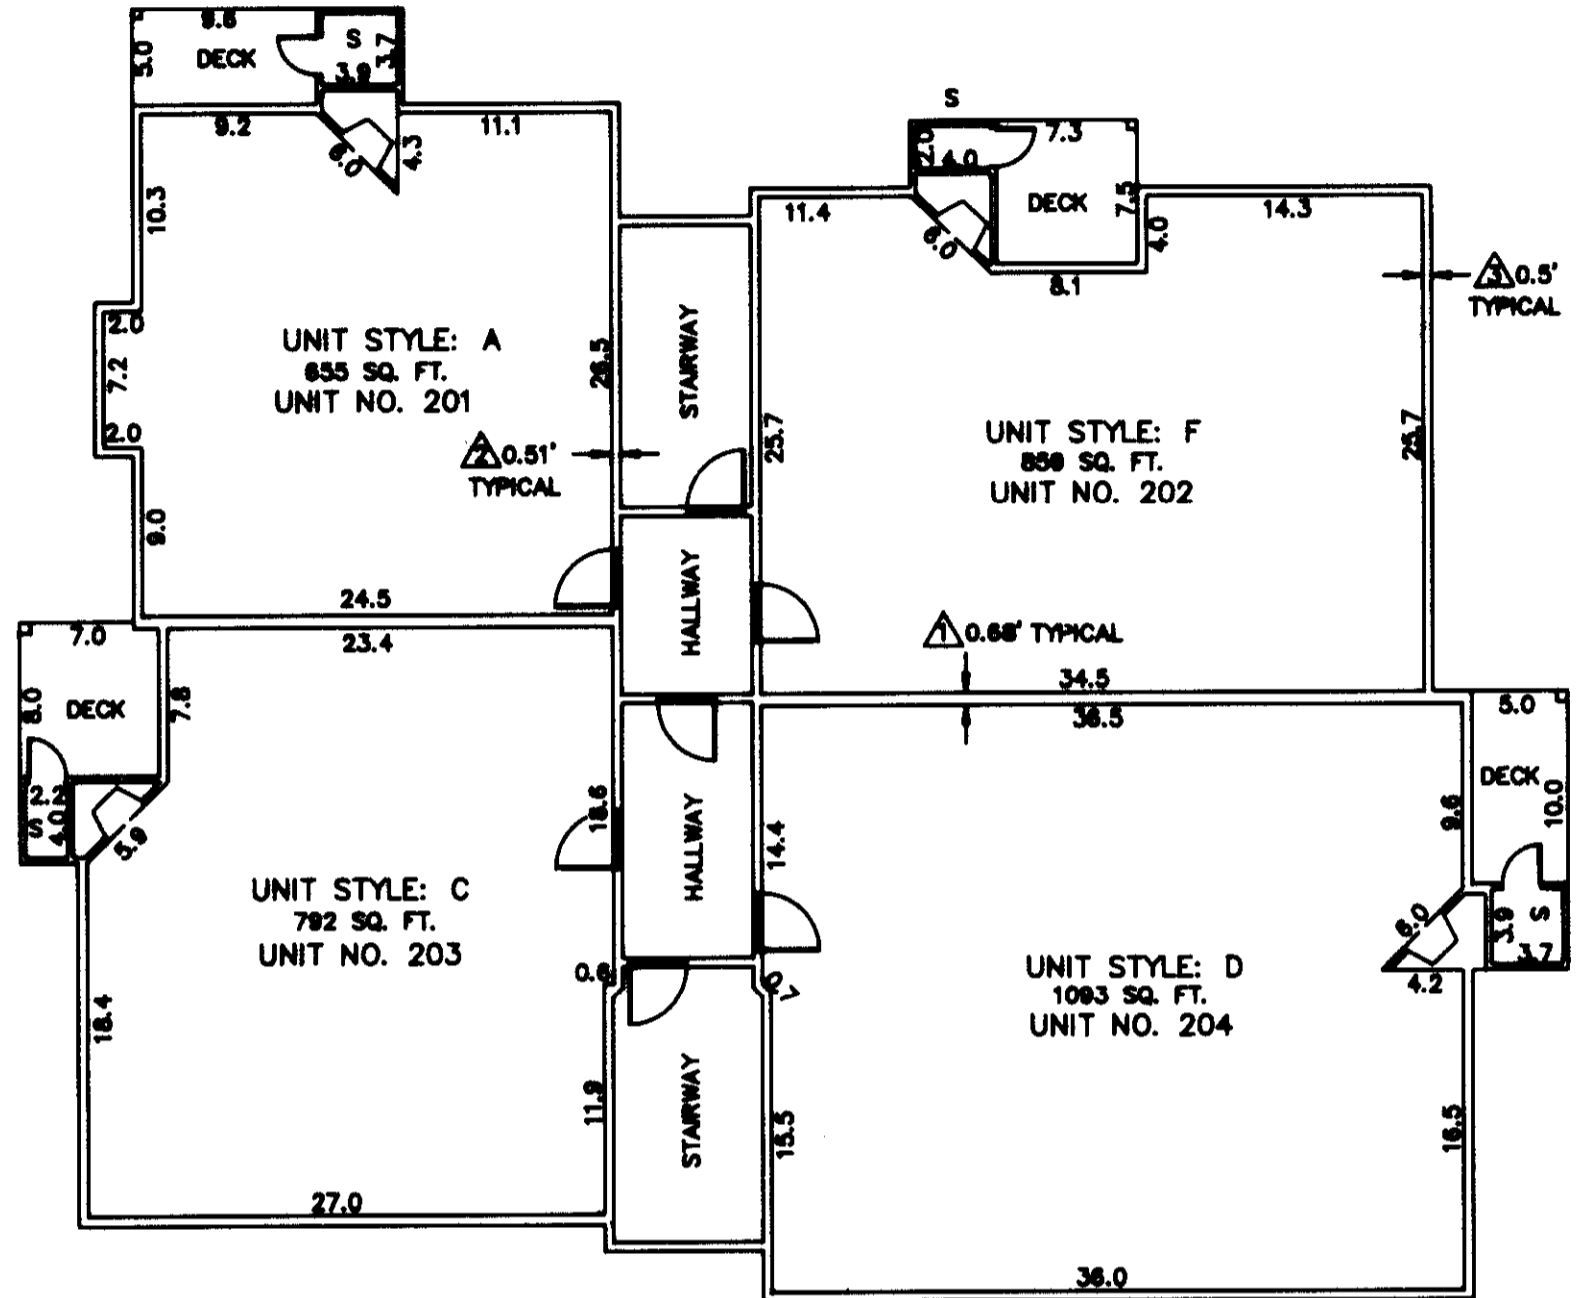

SECOND FLOOR PLAN
TYPICAL ALL BUILDINGS
SCALE 1" = 10'

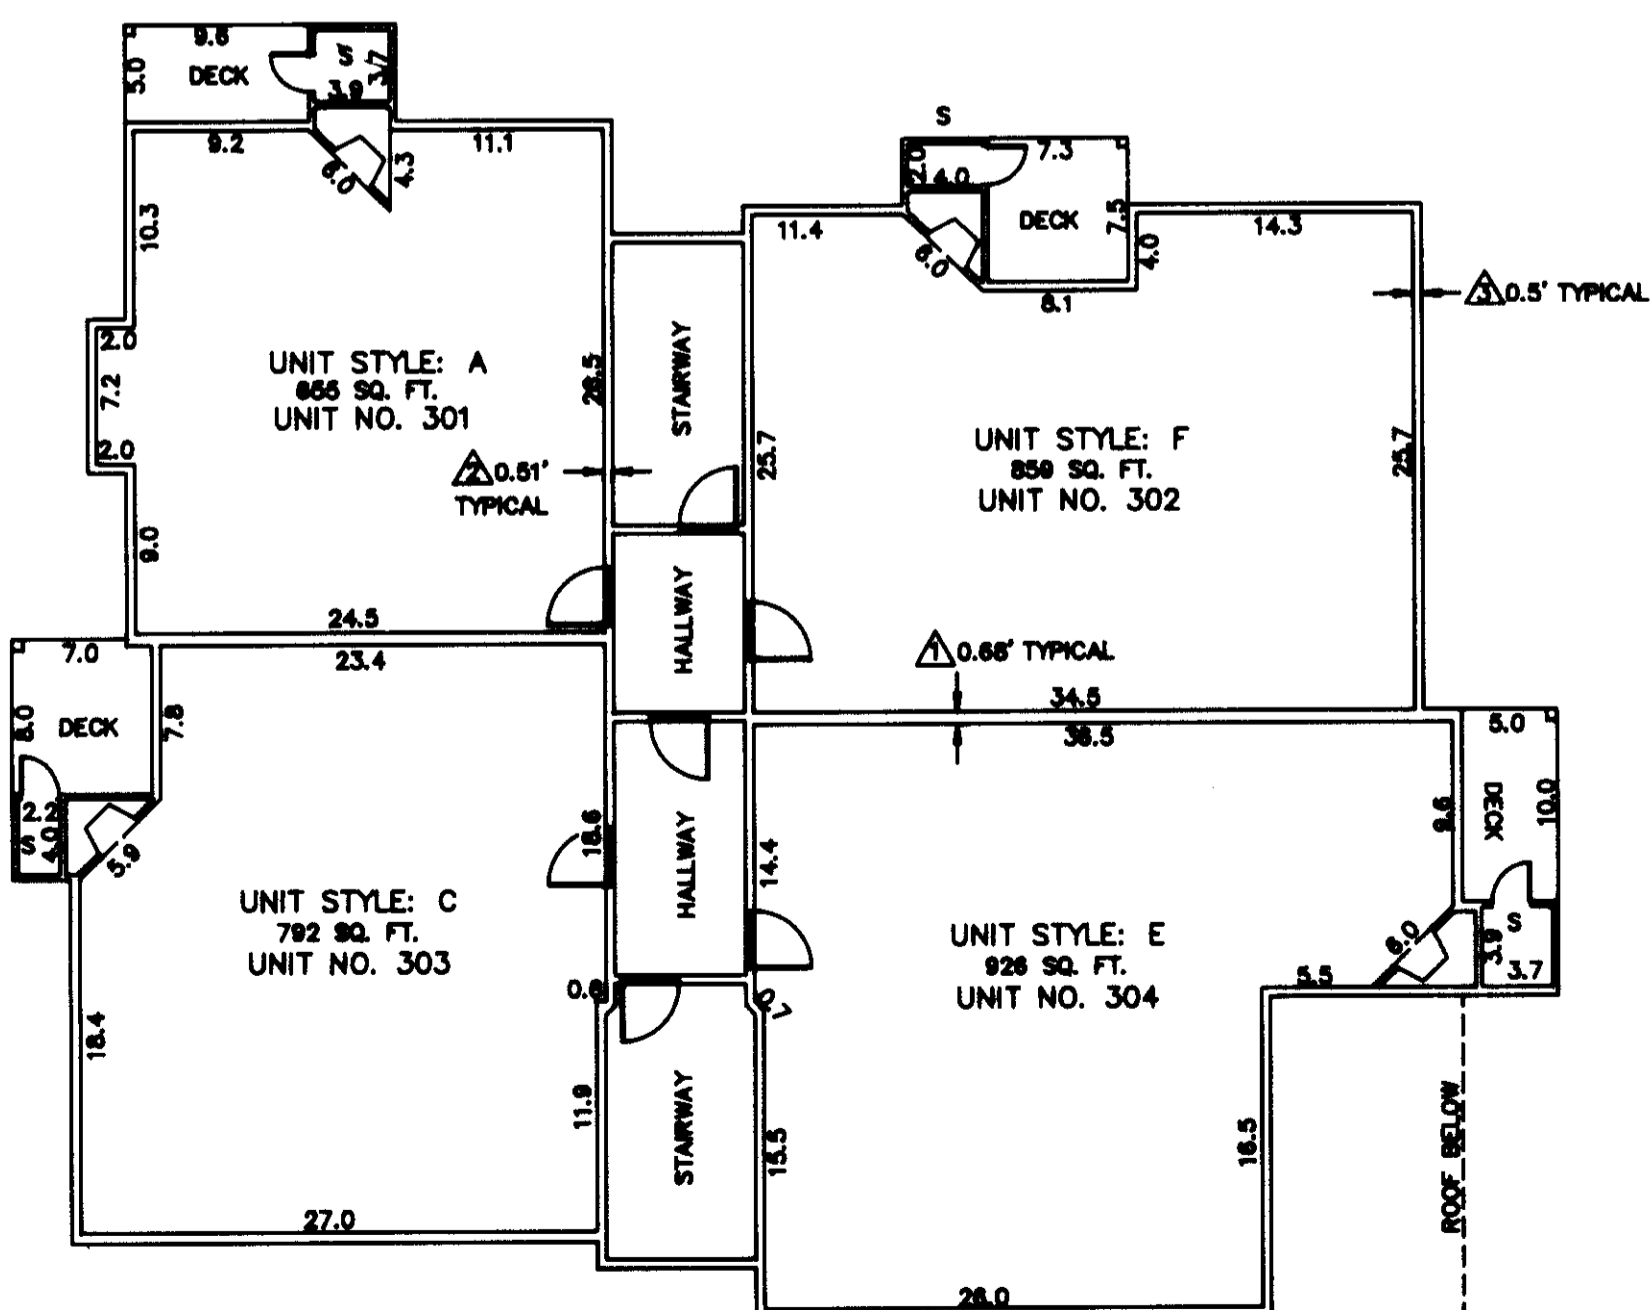

THIRD FLOOR PLAN
TYPICAL ALL BUILDINGS
SCALE 1" = 10'

NOTES:

- 1 THE UNITS SHOWN HEREON ARE LIMITED TO THE AREA ENCLOSED BY THE INTERIOR FRAMING OF THE WALLS, CEILINGS, FLOORS, WINDOWS AND DOORS.
 - 2 ALL ELEVATIONS ARE BASED ON N.G.V.D. 1929, SUPPL. ADJ. OF 1947 AND ARE SHOWN IN FEET AND TENTHS OF A FOOT.
 - 3 THE DIMENSIONS OF THE UNITS SHOWN HEREON ARE IN FEET AND TENTHS OF A FOOT AND ARE IN ACCORDANCE WITH THE AS-BUILT MEASUREMENTS BASED ON MEAN VALUES.
 - 4 ALL BUILDINGS (A,B,C,D,E,F,G,H & J) HAVE IDENTICAL FLOOR PLANS FOR BASIC SHELL OF THE UNITS AND PARKING.
 - 5 THE APPROXIMATE THICKNESS OF CERTAIN PERIMETER WALLS OF OF CERTAIN UNITS AS SHOWN ON THE PLANS IS ONLY ILLUSTRATIVE OF THE WALL THICKNESS AT THE LOCATION SHOWN, IS BASED ON ARCHITECTURAL PLANS, HAS NOT BEEN VERIFIED AND IS NOT CERTIFIED "AS-BUILT".
- ▲ COMMON WALL WIDTH = FACE OF STUD TO FACE OF STUD.
 ▲ CORRIDOR WALL WIDTH = FACE OF STUD TO FACE OF 5/8" GYP. BD.
 ▲ EXTERIOR WALL WIDTH = FACE OF STUD TO FACE OF 1/2" GYP. SHT.

	BUILDING ELEVATION TABLE			
	FIRST FLOOR FLOOR/CEILING	SECOND FLOOR FLOOR/CEILING	THIRD FLOOR FLOOR/CEILING	THIRD FLOOR FLOOR/CEILING
BUILDING A	115.2	123.3	124.1	132.2
BUILDING B	116.7	124.8	125.6	133.7
BUILDING C	119.5	127.6	128.4	136.5
BUILDING D	121.1	128.2	130.0	138.1
BUILDING E	121.1	129.2	130.0	138.1
BUILDING F	119.4	127.5	128.3	136.4
BUILDING G	119.3	127.4	128.2	136.3
BUILDING H	119.6	127.7	128.5	136.6
BUILDING J	120.3	128.4	129.2	137.3

102-76
CONDO.