## A CONDOMINIUM

A PORTION OF THE SOUTHWEST QUARTER OF THE NORTHEAST QUARTER SECTION 22/TOWNSHIP 24 NORTH, RANGE 6 EAST, WILLAMETTE MERIDIAN KING COUNTY, WASHINGTON

#### LEGAL DESCRIPTION

(TOTAL PROPERTY)

THAT PORTION OF THE NORTH HALF DE THE SOUTHWEST QUARTER OF THE NORTHEAST QUARTER OF SECTION 22, TOWNSHIP 24 NORTH, RANGE 6 EAST, WILLAMETTE MERIDIAN, IN KING COUNTY, WASHINGTON, LYING WESTERLY OF THE WESTERLY LINE OF ISSAQUAH-FALL CITY ROAD AS CONVEYED TO KING COUNTY BY INSTRUMENTS RECORDED UNDER REC. NOS. 2721716, 8009230742, AND 8410180377;

except any portion thereof lying easterly of the westerly warring of a king county road being a strip of land 100 feet in width with THE CENTER BEING THE CENTERLINE OF ISSAQUAH-FALL CITY ROAD AS ESTABLISHED BY JUNG COUNTY SURVEY NUMBER 22-24-6-13 AND BY DEED RE-CORDED UNDER RECORDING NUMBER 9809041411, SAID CENTERLINE BEGINNING AT THE SOUTHWEST CORNER OF SECTION 22, TOWNSHIP 24 NORTH, RANGE 6 EAST, WILLAMETTE MERIDIAN, RECORDS OF KING COUNTY:

THENCE SOUTH 88'24'57" EAST A DISTANCE OF 476.30 FEET ALONG THE SOUTH LINE OF SAID SECTION 22;
THENCE NORTH 54'34'34" EAST A DISTANCE OF 2,389.54 FEET TO THE POINT OF BEGINNING AND THE BEGINNING OF A 720.00 FOOT RADIUS TANGENT CURVE TO THE LEFT: THENCE ALONG THE ARC OF SAID 720.00 FOOT RADIUS CURVE THROUGH A CENTRAL ANGLE OF 38'43'08" AN ARC DISTANCE OF 488.56 FEET;

THENCE NORTH 15"51"26" EAST, A DISTANCE OF 869.58 FEET TO THE BEGINNING OF A 1,538.00 FOOT RADIUS TANGENT CURVE TO THE LETT, THENCE ALONG THE ARC OF SAID 1,536.00 FOOT RADIUS CURVE THROUGH A CENTRAL ANGLE OF 33'43'18" AN ARC DISTANCE OF 904.02 FEET; THENCE NORTH 49'34'44" EAST, A DISTANCE OF 401.62 FEET TO THE INTERSECTION OF ISSAGUAH-PINE LAKE ROAD AND THE TERMINUS OF THIS CENTER-LINE DESCRIPTION:

AND EXCEPT THAT PORTION LYING SOUTHEASTERLY OF THE ARC OF A CIRCLE HAVING A RADIUS OF 25 FEET BEING TANGENT TO A LINE 50 FEET NORTHERLY AND PARALLEL TO SAID CENTERLINE OF ISSAQUAH-FALL CITY ROAD AND TANGENT TO A LINE 42 FEET WESTERLY OF AND PARALLEL TO THE CENTERLINE OF ISSAQUAH-PINE LAKE ROAD;

TOGETHER WITH THAT PORTION OF THE SOUTH HALF OF THE SOUTHWEST QUARTER OF THE NORTHEAST QUARTER OF SECTION 22, TOWNSHIP 24 NORTH, RANGE 6 EAST, W.M., LYING WESTERLY OF THE WESTERLY LINE OF THE ISSAQUAH-FALL CITY ROAD AS CONVEYED TO KING COUNTY BY INSTRUMENTS RECORDED UNDER RECORDING NOS. 2721716/AND/8209200697, AND WESTERLY OF THE WESTERLY LINE OF COUNTY ROAD CONVEYED TO KING COUNTY BY DEED RECORDED UNDER RECORDING NO 9805201399;

EXCEPT THAT PORTION THEREOF LYING EASTERLY AND SOUTHERLY OF THE FOLLOWING DESCRIBED LINE:
BEGINNING AT THE SOUTHWEST CORNER OF SAID SUBDIVISION;
THENCE SOUTH 88'19'16" EAST, ALONG THE SOUTH LINE OF SAID SUBDIVISION 132.85 FEET TO THE TRUE POINT OF BEGINNING OF THIS EXCEPTION;

THENCE NORTH 01"36"43" EAST, PARALLEL TO THE WEST LINE OF SAID SUBDIVISION, 96.42 FEET;
THENCE NORTH 88"35"31" EAST TO THE WESTERLY RIGHT OF WAY MARGIN OF SAID ISSAQUAH-FALL CITY ROAD AND THE TERMINUS OF SAID LINE;

SITUATE IN THE COUNTY OF KING, STATE OF WASHINGTON:

#### LEGAL DESCRIPTION/

THAT PORTION OF THE NORTH HALF OF THE SOUTHWEST QUARTER OF THE NORTHEAST QUARTER OF SECTION 22, TOWNSHIP 24 NORTH, RANGE 6 EAST, W.M. IN KING COUNTY, WASHINGTON, LYING WESTERLY OF THE WESTERLY LINE OF ISSAQUAN-FALL CITY ROAD-AS-CONVEYED TO KING COUNTY BY INSTRUMENTS RECORDED UNDER RECORDING NUMBERS 2721716, 8609230742, AND 8410180377, AND WESTERLY OF THE WEST-LINE OF ISSAQUAN-FALL CITY ROAD AS ESTABLISHED BY KING COUNTY SURVEY NUMBER 22-24-6-13 AND BY DEED RECORDED UNDER RECORDING, NUMBER, 9809041411, DESCRIBED AS FOLLOWS:

COMMENCING AT THE SOUTHEAST CORNER OF THE ABOVE DESCRIBED PARCEL; THENCE NORTH 88'10'44" WEST ALONG THE SOUTH LINE PHEREOP, 194.56 FEET TO THE SOUTHWEST CORNER OF SUMMERHILL VILLAGE (PHASE 1), AS RE-

CORDED IN VOLUME 157 OF CONDOMINIUMS, AT PAGES 62-70 RECORDS OF KING COUNTY, WASHINGTON;

THENCE NORTHERLY ALONG THE WEST LINE OF SAID SUMMERHILL VILLAGE (PHASE 1), THE FOLLOWING COURSES: NORTH 13"51"27" WEST, 97.69 FEET:

THENCE NORTH 71°13'30" EAST, 70.00 FEET TO THE TRUE POINT OF BEGINNING;

THENCE NORTH 2711'37" EAST, 132.22 FEET; THENCE NORTH 43'40'28" EAST, 241.20 FEET;

THENCE NORTH 05'43'28" EAST, 65.00 FEET; THENCE NORTH 65'46'38" EAST, 166.61 FEET;

THENCE MORTH 03'58'53" WEST, 98.11 FEET TO THE MORTHWEST CORNER OF SAID SUMMERHIEL VIELAGE (PHASE 1), SAID POINT ALSO BEING ON THE MORTH

LINE OF THE ABOVE REFERENCED SUBDIVISION; THENCE NORTH 88'00'36" WEST ALONG THE NORTH LINE OF SAID NORTH HALF OF THE SOUTHWEST QUARTER OF THE NORTHEAST QUARTER, 344.24 FEET;

THENCE SOUTH 01"59'24" WEST, 145.00 FEET;

THENCE SOUTH 88'42'43" EAST, 95.70 FEET; thence south 01°59'24" West, 25.15 Feet;

THENCE SOUTH 07"19"02" WEST, 80.60 FEET;

THENCE SOUTH 30'26'14" WEST, 171.93 FEET; THENCE SOUTH 09"20"52" WEST, 84.70 FEET:

THENCE SOUTH 14'32'29" WEST, 52.66 FEET TO THE POINT OF BEGINNING.

### LEGAL DESCRIPTION (SUBSEQUENT PHASE PROPERTY)

THAT PORTION OF THE NORTH HALF OF THE SOUTHWEST QUARTER OF THE NORTHEAST QUARTER OF SECTION 22, TOWNSHIP 24 NORTH, RANGE 6 EAST, W.M. In king county, washington, lying westerly of the westerly line of issaquah—fall city road as conveyed to king county by instruments RECORDED UNDER RECORDING NUMBERS 2721716, 8009230742, AND 8410180377, AND WESTERLY OF THE WEST LINE OF ISSAQUAH-FALL CITY ROAD AS ESTAB-LISHED BY KING COUNTY SURVEY NUMBER 22-24-6-13 AND BY DEED RECORDED UNDER RECORDING NUMBER 9809041411;

EXCEPT THAT PORTION THEREOF LYING EASTERLY OF THE FOLLOWING DESCRIBED LINE: COMMENCING AT THE SOUTHEAST CORNER OF THE ABOVE DESCRIBED PARCEL;

THENCE NORTH BE'10'44" WEST ALONG THE SOUTH LINE THEREOF, 194.56 FEET TO THE TRUE POINT OF BEGINNING:

THENCE NORTH 13"51"27" WEST, 97.69 FEET;

THENCE NORTH 71"13"30" EAST, 70.00 FEET;

THENCE NORTH 14'32'29" EAST, 52.66 FEET; THENCE NORTH 09'20'52" EAST, 84.70 FEET; THENCE NORTH 30'26'14" EAST, 71.93 FEET;

THENCE NORTH 07'19'02" EAST, 80.60 FEET;

THENCE NORTH 01°59'24" EAST, 25.15 FEET;

THENCE NORTH 88'42'43" WEST, 95.70 FEET;

THENCE NORTH 01°59'24" WEST, 145.00 FEET TO THE NORTH LINE OF SAID PARCEL AT A POINT THAT IS NORTH 88'00'36" EAST FROM THE NORTHEAST

CORNER THEREOF, AND THE TERMINUS OF THIS LINE. TOGETHER WITH THAT PORTION OF THE SOUTH HALF OF THE SOUTHWEST QUARTER OF THE NORTHEAST QUARTER OF SECTION 22, TOWNSHIP 24 NORTH, RANGE 6 EAST, W.M., LYING WESTERLY OF THE WESTERLY LINE OF THE ISSAQUAH-FALL CITY ROAD AS CONVEYED TO KING COUNTY BY INSTRUMENTS RE-CORDED UNDER RECORDING NOS. 2721716 AND 8209200697, AND WESTERLY OF THE WESTERLY LINE OF COUNTY ROAD CONVEYED TO KING COUNTY BY

DEED RECORDED UNDER RECORDING NO. 9803201399: EXCEPT THAT PORTION THEREOF LYING EASTERLY AND SOUTHERLY OF THE FOLLOWING DESCRIBED LINE:

BEGINNING AT THE SOUTHWEST CORNER OF SAID SUBDIVISION:

THENCE SOUTH 88"19"16" EAST, ALONG THE SOUTH LINE OF SAID SUBDIVISION 132.85 FEET TO THE TRUE POINT OF BEGINNING OF THIS EXCEPTION;

THENCE NORTH 01'36'43" EAST, PARALLEL TO THE WEST LINE OF SAID SUBDIVISION, 96.42 FEET; THENCE NORTH 88"35"31" EAST TO THE WESTERLY RIGHT OF WAY MARGIN OF SAID ISSAQUAH-FALL CITY ROAD AND THE TERMINUS OF SAID LINE:

#### **DEDICATION**

KNOW ALL MEN BY THESE PRESENTS, THAT WE, THE UNDERSIGNED OWNERS IN FEE SIMPLE OF THE REAL PROPERTY DESCRIBED HEREIN, HEREBY DEDICATE THE REAL PROPERTY DESCRIBED IN THIS SURVEY MAP AND THESE PLANS FOR CONDOMINIUM PURPOSES. THE DRIVES, WALKS, STREETS, GROUNDS AND OTHER AREAS DESCRIBED HEREIN ARE NOT DEDICATED TO THE PUBLIC, BUT ARE PRESERVED FOR THE EXCLUSIVE USE AND BENEFIT OF THE UNIT CHAIRERS, AS PART OF THE COMMON ELEMENTS, TO THE EXTENT AND IN THE MANNER SET FORTH IN THE DECLARATION. WE, THE UNDERSIGNED OWNERS OF THE PROPERTY, HEREBY CERTIFY THAT ALL STRUCTURAL COMPONENTS AND MECHANICAL SYSTEMS OF ALL BUILDINGS CONTAINING OR COMPRISING UNITS HEREBY 1999 1026 000857

IN WITNESS THEREOF WE HAVE SET OUR HANDS AND SEAL

MACLEAN SOUTH, L.L.C., A WASHINGTON LIMITED LIABILITY COMPANY

BY: POLYGON NORTHWEST COMPANY

A WASHINGTON GENERAL PARTNERSHIP

BY: BRENTVIEW, INC., A WASHINGTON CORPORATION

BY: Eric H.O.Wells ITS: Mill-horized Agent

MACLEAN TOWNHOMES, LL.C., A WASHINGTON LIMITED LIABILITY COMPANY

BY: POLYGON NORTHWEST COMPANY,

A WASHINGTON GENERAL PARTNERSHIP

BY: BRENTVIEW, INC., A WASHINGTON CORPORATION

E. H.L. Wils BY: Bric H.G. Wells IIS: Authorized A.

#### **ACKNOWLEDGMENTS**

STATE OF WASHINGTON COUNTY OF KING

CERTIFY THAT I KNOW OR HAVE SATISFACTORY EVIDENCE THAT EMC H. LUCKS IS THE PERSON WHO APPREARED BEFORE, ME, AND SAID PERSON ACKNOWLEDGED THAT (S)HE SIGNED THIS INSTRUMENT, ON OATH . Stated (S)HE MAS AUTHORIZED TO EXECUTE THE INSTRUMENT AND ACKNOWLEDGED IT AS THE AUTHORIZED AGENT 'OF BRENTYIEW, MIC. THE MANAGING PARTNER OF POLYGON NORTHWEST COMPANY, THE MANAGER OF MACLEAN TOWNHOMES, LALC, A WASHINGTON LIMITED TWENLTY COMPANY, AND ACKNOWLEDGED THAT (SHE IS AUTHORIZED TO SIGN THIS INSTRUMENT AND ACKNOWLEDGED IT—TO BE THE FREE AND VOLUNTARY ACT OF SAID LIMITED LIABILITY COMPANY FOR THE USES AND PURPOSES MENTIONED IN THE INSTRUMENT.


DATED THIS 18 DAY OF ACTION 1908

NOTARY PUBLIC IN AND FOR THE STATE OF WASHINGTON RESIDING AT DELEGARE 

STATE OF WASHINGTON

I CERTIFY THAT I KNOW OR HAVE SATISFACTORY EMBENCE THAT STICK IS THE PERSON WHO APPEARED BEFORE ME, AND SAID PERSON ACKNOWLEDGED THAT (S)HE SIGNED THIS INSTRUMENT, ON OATH STATED (S)HE WAS AUTHORIZED TO EXECUTE THE INSTRUMENT AND ACKNOWLEDGED IT AS THE AUTHORIZED ACENT OF BRENTYIEW, INC., THE MANAGING PARTIER OF POLYCON NORTHWEST COMPANY, THE MANAGER OF MACLEAN SOUTH, L.L.C., A WASHINGTON LIMITED LIABILITY COMPANY, AND ACKNOWLEDGED THAT (S)HE IS AUTHORIZED TO SIGN THIS INSTRUMENT AND ACKNOWLEDGED IT TO BE THE FREE AND VOLUNTARY ACT OF SAID LIMITED LIA-BILITY COMPANY FOR THE USES AND PURPOSES MENTIONED IN THE INSTRUMENT

DATED THIS 18 DAY OF OCCUPENT. 1999. NOTARY PUBLIS IN AND FOR THE STATE OF WASHINGTON RESIDING AT DATE REPORT RECOMMISSION EXPIRES 3-22-02

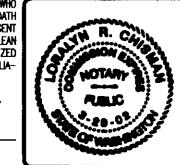

VOLUME/PAGE

#### LAND SURVEYOR'S CERTIFICATE

F HEREBY CERTIFY THAT THESE PLANS FOR SUMMERHILL VILLAGE PHASE 2, A CONDOMINIUM, ARE BASED UPON AN ACTUAL SURVEY OF THE PROPERTY DESCRIBED HEREIN AND THAT THE COURSES AND DISTANCES ARE SHOWN ACCURATELY THEREON AND THAT THESE PLANS ACCURATELY DEPICT THE LOCATION AND DIMENSIONS OF THE UNITS AS-BUILT. THESE PLANS ARE PER THE BASIC REQUIREMENTS PURSUANT TO ROW 64,34,262, AND THAT ALL HORIZONTAL AND VERTICAL BOUNDARIES OF THE UNITS ARE SUBSTANTIALLY COMPLETED IN ACCORDANCE WITH SAID PLANS.

DENNIS J. SALTYS, PLS 27328

#### LAND SURVEYOR'S VERIFICATION

STATE OF WASHINGTON

DENNIS J. SALTYS, BEING FIRST ON OATH OULY SWORN, STATES THAT HE IS THE REGISTERED PROFESSIONAL LAND SURVEYOR SIGNING THE ABOVE CERTIFICATE, THAT HE HAS EXAMINED THESE PLANS AND SURVEY MAP, AND BELIEVES THE CERTIFICATE TO BE A TRUE STATEMENT.

DENNIS J. SALTYS, REGISTERED PROFESSIONAL LAND SURVEYOR NUMBER 27328

NOTARY PUBLIC IN AND FOR THE STATE OF RESIDING AT PRINTED NAME COMMISSION EXPIRES 447

APPROVAL

EXAMINED AND APPROVED THIS 25th DAY OF

### RECORDING CERTIFICATE

FILED FOR RECORD AT THE REQUEST OF A LICINIS 26 DAY OF OF MINUTES PAST /: 00 O'CLOCK AND RECORDED IN VOLUME/60 OF CONDOMINANS, PAGES /- RECORDS OF KING COUNTY, WASHINGTON.

DEPARTMENT OF RECORDS AND ELECTIONS

99/026000 856 RECORDING NUMBER

SUPERINTENDENT OF RECORDS


JOB NO. 5903


PIRES 01 - 15 - 00

Barghausen Consulting Engineers, Inc. Civil Engineering, Land Planning, Surveying, Environmental Services

18215 72nd Avenue South Kent, WA. 98032 Telephone: (425) 251-6222 Fax: (425) 251-8782 SW1/4, NE1/4 SEC. 22-24N-6E

SHEET 1 OF 8

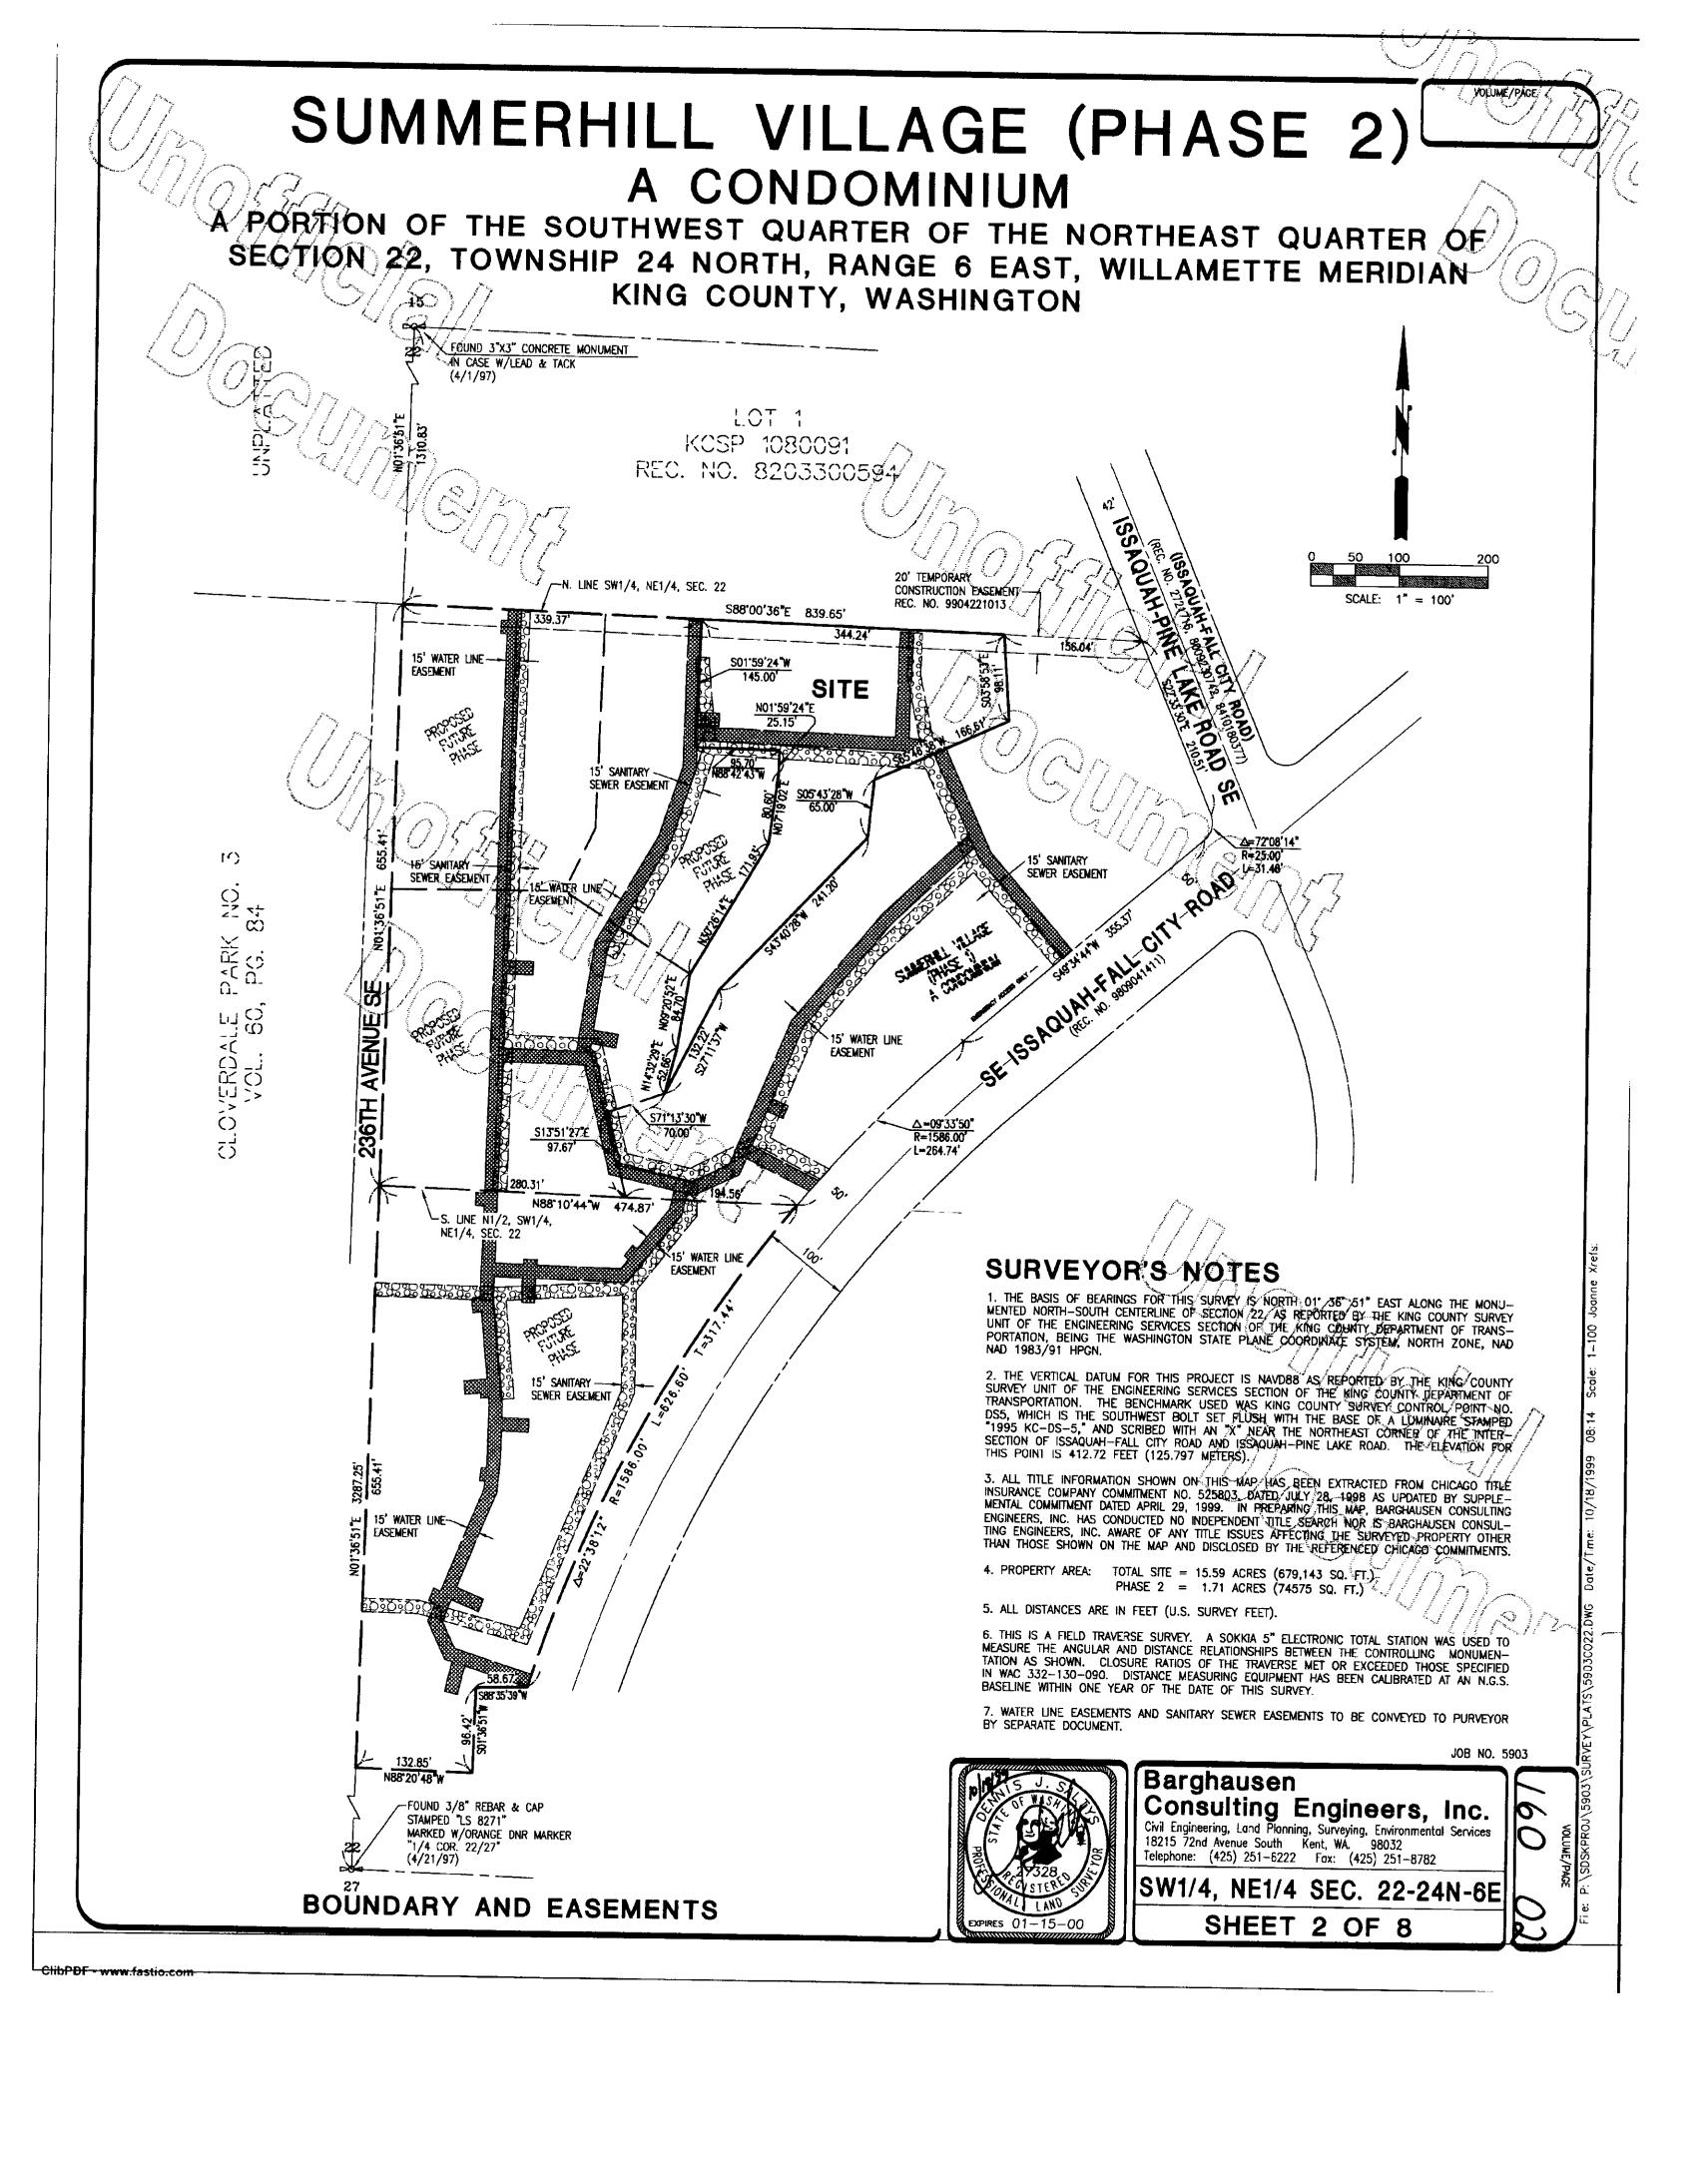

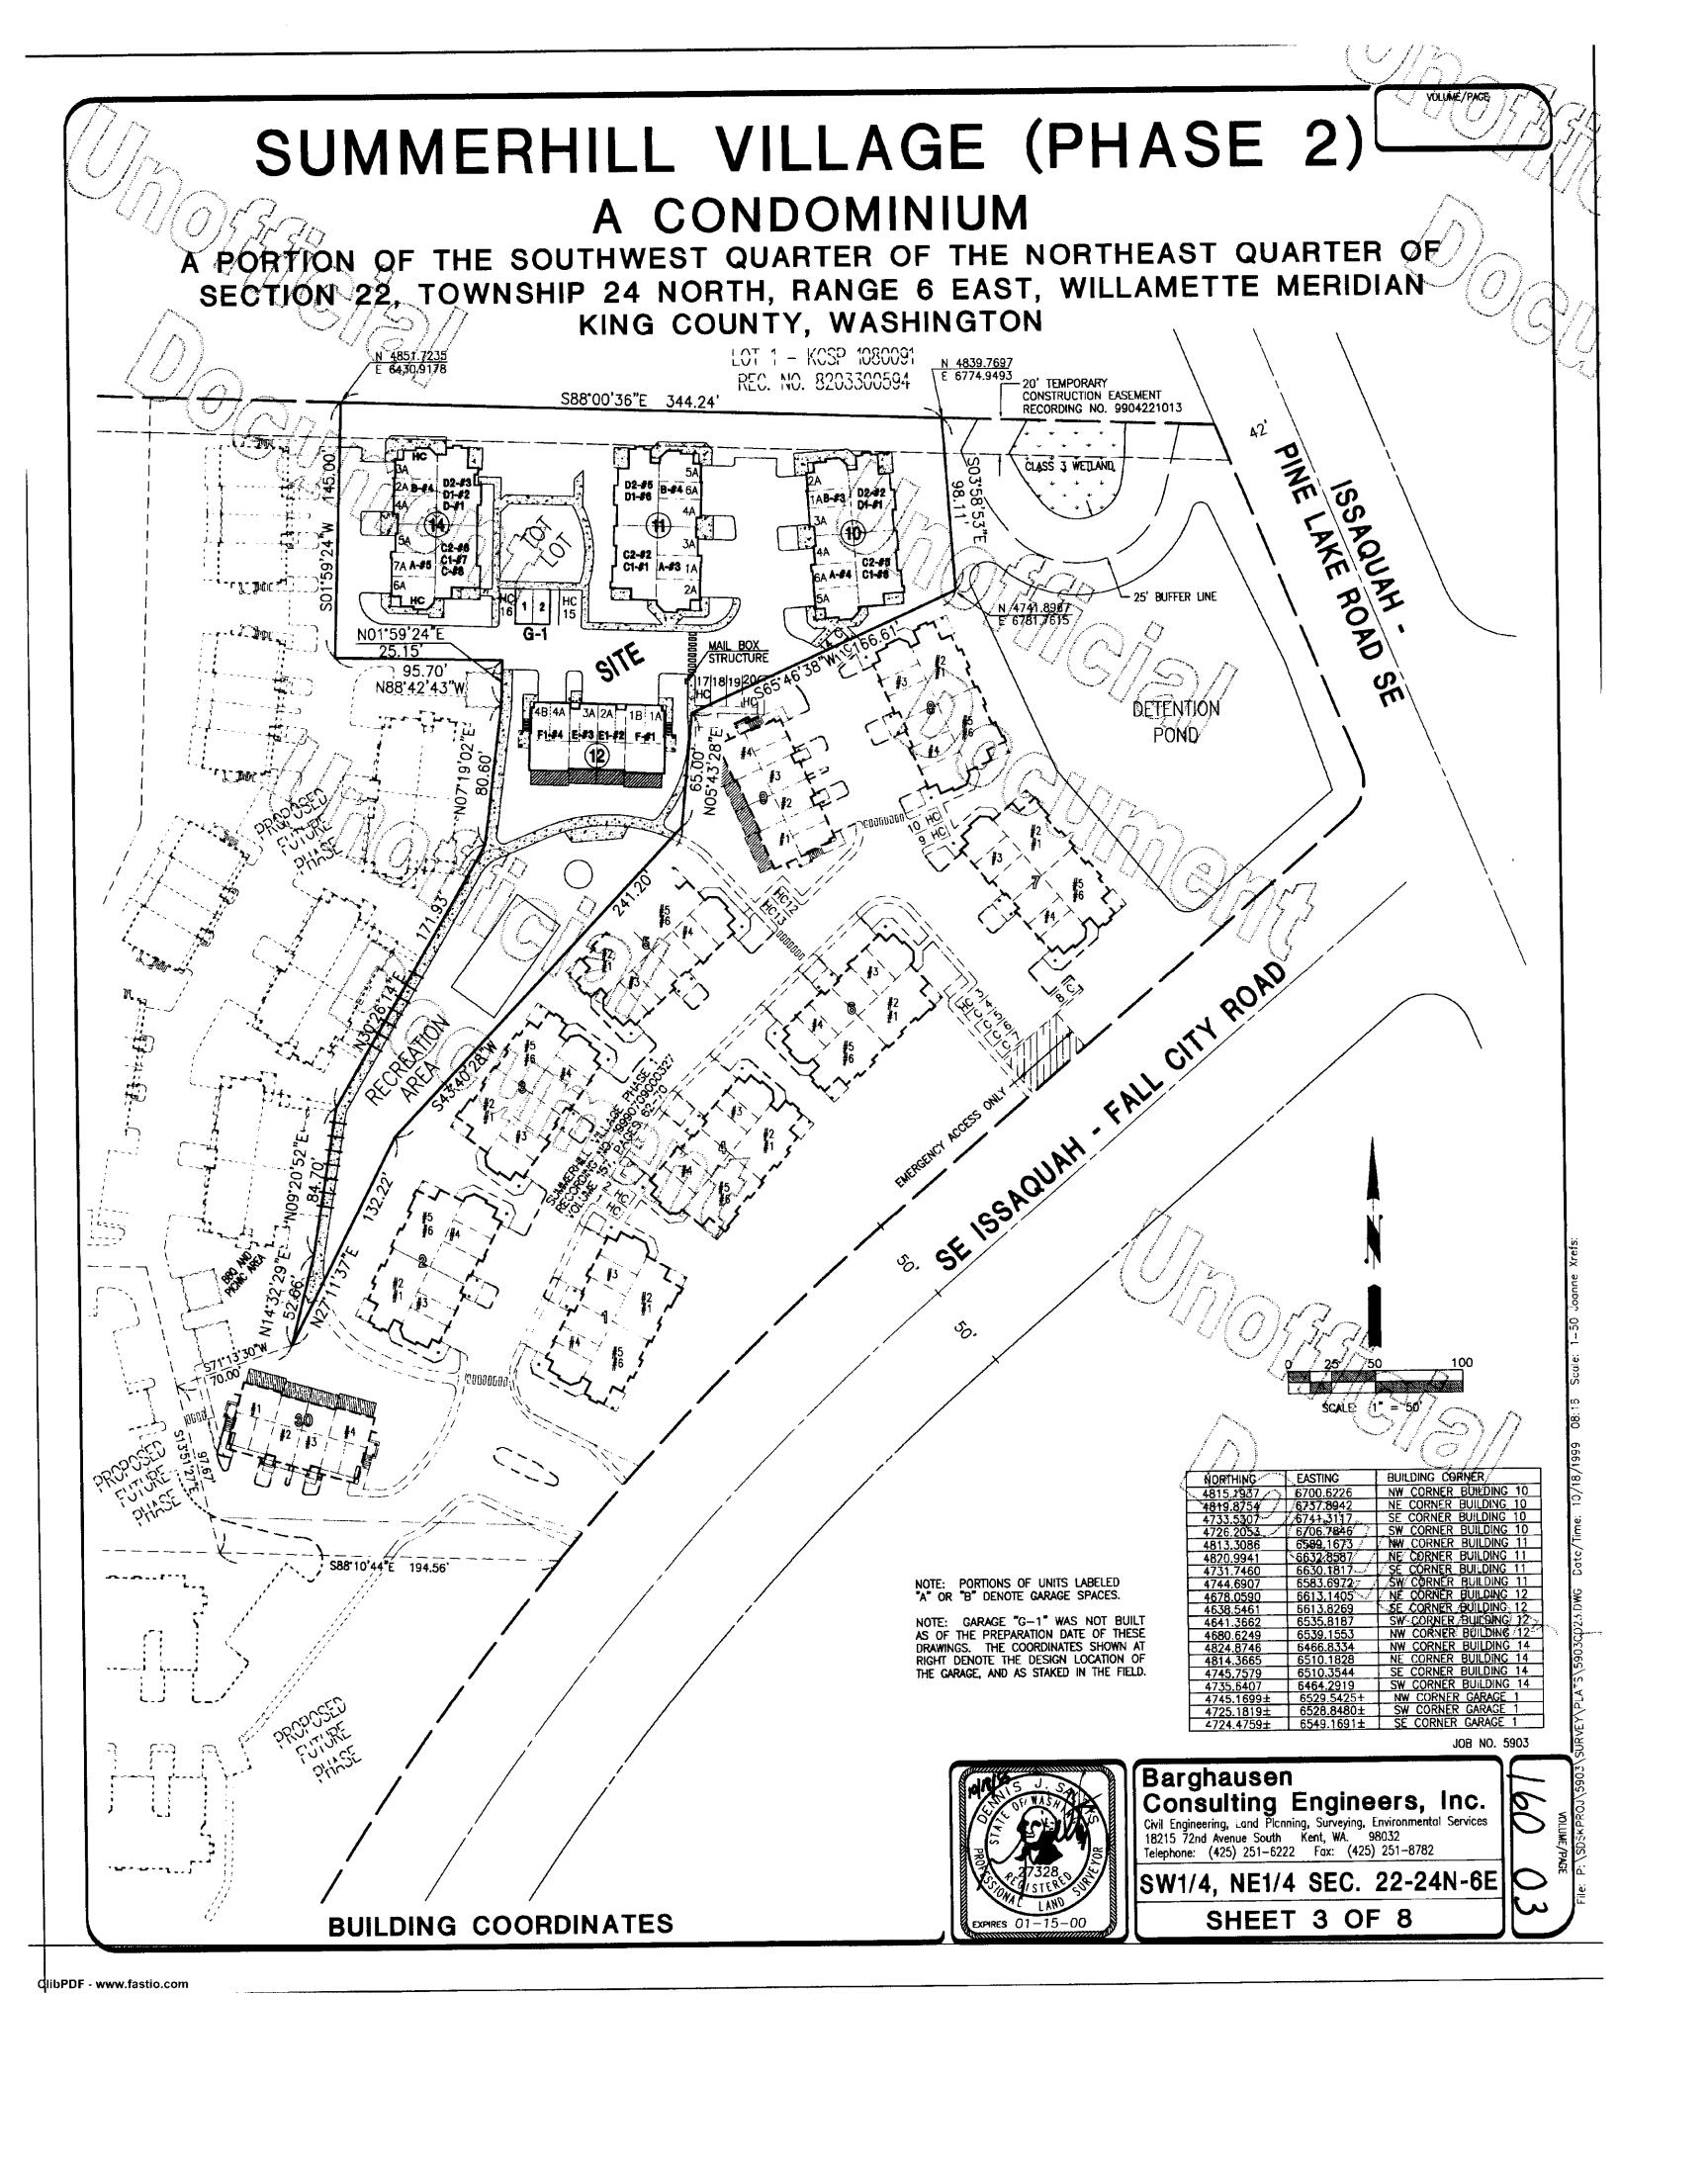


# SUMMERHILL VILLAGE (PHASE 2)

A CONDOMINIUM

A PORTION OF THE SOUTHWEST QUARTER OF THE NORTHEAST QUARTER OF SECTION 22, TOWNSHIP 24 NORTH, RANGE 6 EAST, WILLAMETTE MERIDIAN KING COUNTY, WASHINGTON



BLDG. 10, UNIT 6, MIRROR IMAGE BLDG. 11, UNIT 1 BLDG. 14, UNIT 7, MIRROR IMAGE

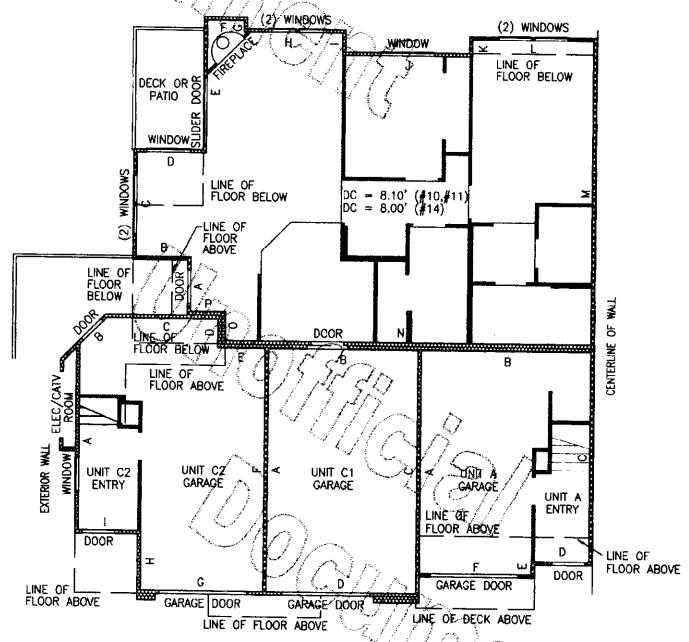

## GARAGES FOR UNIT TYPES A C2

1" = 8'

UNIT A

BLDG. 10, UNIT 4, MIRROR IMAGE
BLDG. 11, UNIT 3
BLDG. 14, UNIT 4, MIRROR IMAGE

GlibPDF - www.fastio.ed

UNIT C1


BLDG. 10, UNIT 6, MIRROR IMAGE
BLDG. 11, UNIT 1

BLDG. 14, UNIT 7, MIRROR IMAGE

GARAGE PLAN

UNIT C2


BLDG. 10, UNIT 5, MIRROR IMAGE
BLDG. 11, UNIT 2
BLDG. 14, UNIT 5, MIRROR IMAGE

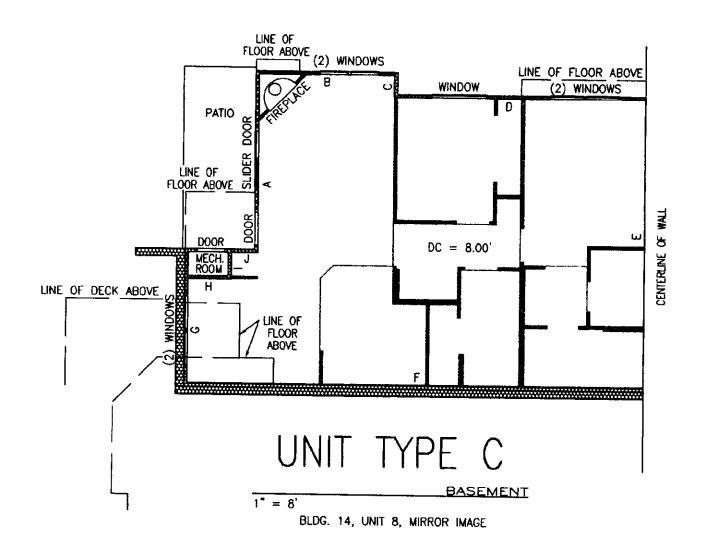

## UNIT TYPE C2

1" = 8'

BLDG. 10, UNIT 5, MIRROR IMAGE BLDG. 11, UNIT 2 BLDG. 14, UNIT 5, MIRROR IMAGE

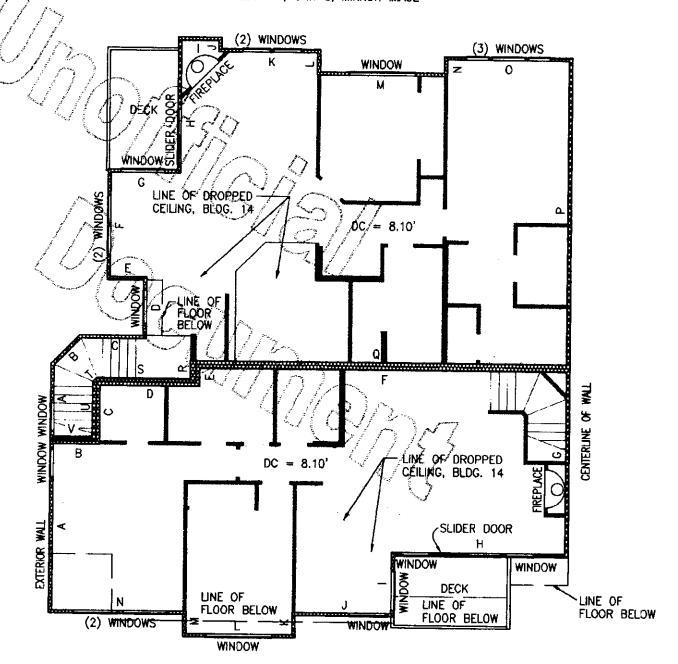

### UNIT TYPE A

SECOND FLOOR PLAN

BLDG. 10. UNIT 4, MIRROR IMAGE BLDG. 11, UNIT 3 BLDG. 14, UNIT 6, MIRROR IMAGE


NOTES:

1. UNLESS OTHERWISE NOTED OR SHOWN HEREON, DIMENSIONS ARE ON THE INNER FACE OF THE OUTER WALL OF THE UNIT. INNER WALLS ARE SHOWN FOR LAYOUT PURPOSES ONLY.

2. UNIT LAYOUT IS FROM PLANS BY MILBRANDT ARCHITECTS, SHEETS U-1 THROUGH U-16, WITH REVISION DATE OF 11-19-97.

SEE SHEET 8 FOR UNIT DIMENSIONS AND CEILING HEIGHTS. DROP CEILING (D.C.) HEIGHTS ARE SHOWN ON UNIT LAYOUT SHEETS 4 THROUGH 7 OF 8.

JOB NO. 5903

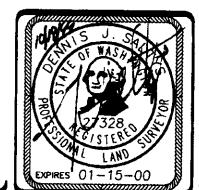

# Barghausen Consulting Engineers, Inc. Civil Engineering, Land Planning, Surveying, Environmental Services 18215 72nd Avenue South Kent, WA 98032

18215 72nd Avenue South Kent, WA. 98032 Telephone: (425) 251-6222 Fax: (425) 251-8782

SW1/4, NE1/4 SEC. 22-24N-6E

SHEET 4 OF 8




# SUMMERHILL VILLAGE (PHASE 2)

A CONDOMINIUM

A PORTION OF THE SOUTHWEST QUARTER OF THE NORTHEAST QUARTER OF SECTION 22, TOWNSHIP 24 NORTH, RANGE 6 EAST, WILLAMETTE MERIDIAN KING COUNTY, WASHINGTON

## UNITATYPE D1

BLDG. 10, UNIT 1, MIRROR IMAGE
BLDG. 11, UNIT 6
BLDG. 14, UNIT 1, MIRROR IMAGE

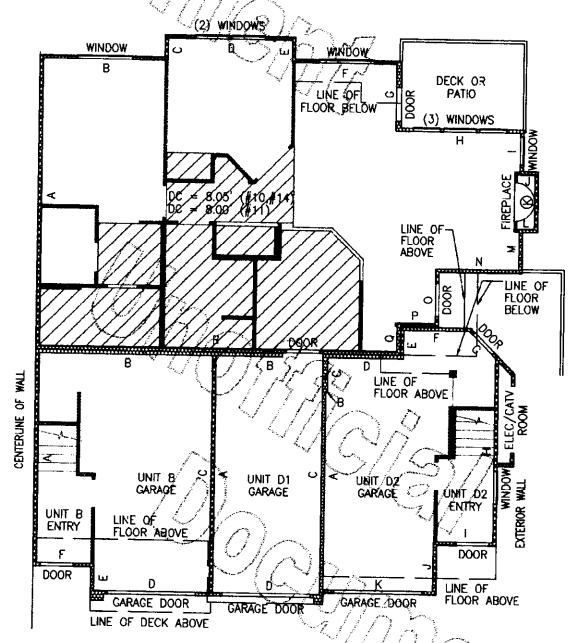

## GARAGES FOR UNIT TYPES B D2

UNIT B

UNIT D1

UNIT D2

BLDG. 10, UNIT 3, MIRROR IMAGE
BLDG. 11, UNIT 4


BLDG. 11, UNIT 4

BLDG. 11, UNIT 6

BLDG. 11, UNIT 6

BLDG. 14, UNIT 3, MIRROR IMAGE
BLDG. 14, UNIT 1, MIRROR !MAGE
BLDG. 11, UNIT 5


BLDG. 14, UNIT 2, MIRROR IMAGE

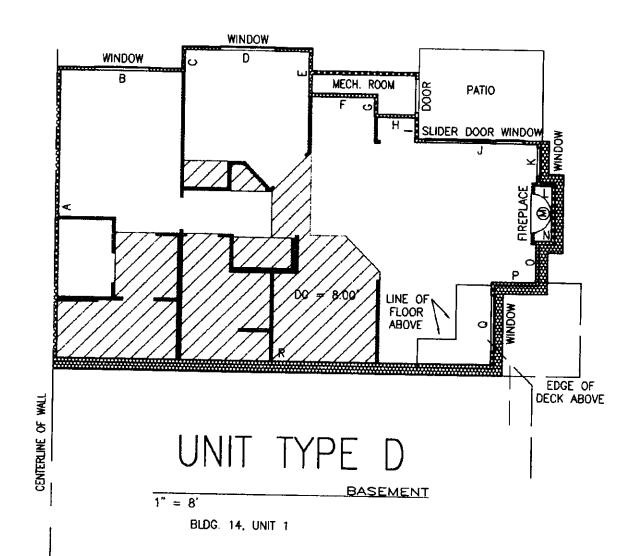

## UNIT TYPE D2

SECOND FLOOR PLAN

BLDG. 10, UNIT 2, MIRROR IMAGE BLDG. 11, UNIT 5 BLDG. 14, UNIT 2, MIRROR IMAGE

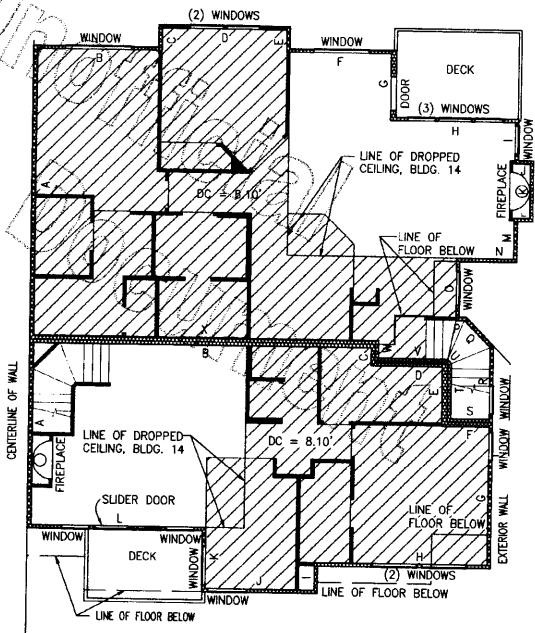

## UNIT TYPE B

SECOND FLOOR PLAN

1" = 8'

BLDG. 10 JINIT 3 MIRROR IMAGE

BLDG. 10, UNIT 3, MIRROR IMAGE BLDG. 14, UNIT 3, MIRROR IMAGE




1. UNLESS OTHERWISE NOTED OR SHOWN HEREON, DIMENSIONS ARE ON THE INNER FACE OF THE OUTER WALL OF THE UNIT. INNER WALLS ARE SHOWN FOR LAYOUT PURPOSES ONLY.

2. UNIT LAYOUT IS FROM PLANS BY MILBRANDT ARCHITECTS, SHEETS U-1 THROUGH U-16, WITH REVISION DATE OF 11-19-97.

SEE SHEET 8 FOR UNIT DIMENSIONS AND CEILING HEIGHTS. DROP CEILING (D.C.) HEIGHTS ARE SHOWN ON UNIT LAYOUT SHEETS 4 THROUGH 7 OF 8.

JOB NO. 5903

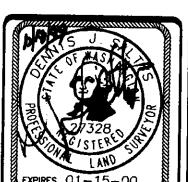

# Barghausen Consulting Engineers, Inc. Civil Engineering, Land Planning, Surveying, Environmental Services 18215, 72nd Avenue South Kost WA 08072


18215 72nd Avenue South Kent, WA. 98032
Telephone: (425) 251-6222 Fax: (425) 251-8782

SW1/4, NE1/4 SEC. 22-24N-6E SHEET 5 OF 8 160 05


libPDF - www.fastio.com



PORTION OF THE SOUTHWEST QUARTER OF THE NORTHEAST QUARTER OF SECTION 22, TOWNSHIP 24 NORTH, RANGE 6 EAST, WILLAMETTE MERIDIAN KING COUNTY, WASHINGTON

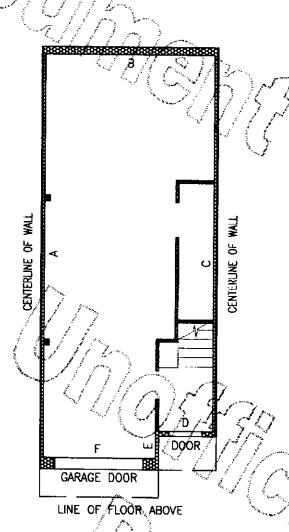

DECK OR SLIDER DOÓR LINE OF FLOOR BELOW (2) WINDOWS

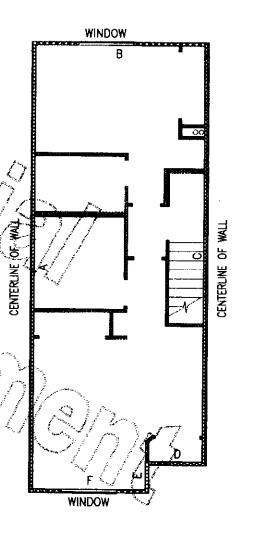

BLDG. 12, UNIT 2, MIRROR JMAG BLDG. 12, UNIT 3

BLDG. 12, UNIT 2, MIRROR IMAGE BLDG. 12, UNIT 3

BLDG. 12, UNIT 3

FLOOR BELOW

BLDG. 12, UNIT 2, MIRROR IMAGE


NOTES:

1. UNLESS OTHERWISE NOTED OR SHOWN HEREON, DIMENSIONS ARE ON THE INNER FACE OF THE OUTER WALL OF THE UNIT. INNER WALLS ARE SHOWN FOR LAYOUT PURPOSES ONLY.

2. UNIT LAYOUT IS FROM PLANS BY MILBRANDT ARCHITECTS, SHEETS U-1 THROUGH U-16, WITH REVISION DATE OF 11-19-97.

SEE SHEET 8 FOR UNIT DIMENSIONS AND CEILING HEIGHTS. DROP CEILING (D.C.) HEIGHTS ARE SHOWN ON UNIT LAYOUT SHEETS 4 THROUGH 7 OF 8.

JOB NO. 5903

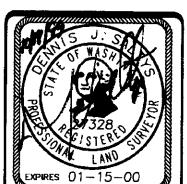

Barghausen Consulting Engineers, Inc.
Civil Engineering, Land Planning, Surveying, Environmental Services
18215 72nd Avenue South Kent, WA. 98032
Telephone: (425) 251-6222 Fax: (425) 251-8782


SW1/4, NE1/4 SEC. 22-24N-6E


SHEET 6 OF 8


-ClibPDF - www.fastio.com

A CONDOMINIUM

A PORTION OF THE SOUTHWEST QUARTER OF THE NORTHEAST QUARTER OF SECTION 22, TOWNSHIP 24 NORTH, RANGE 6 EAST, WILLAMETTE MERIDIAN KING COUNTY, WASHINGTON

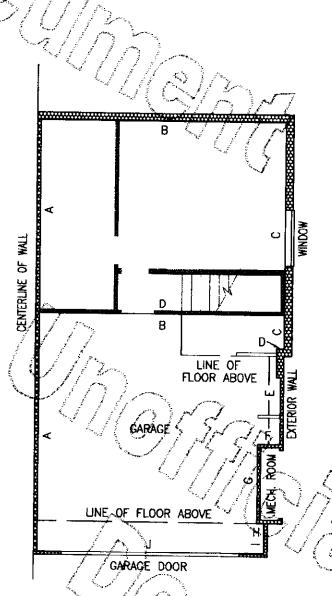

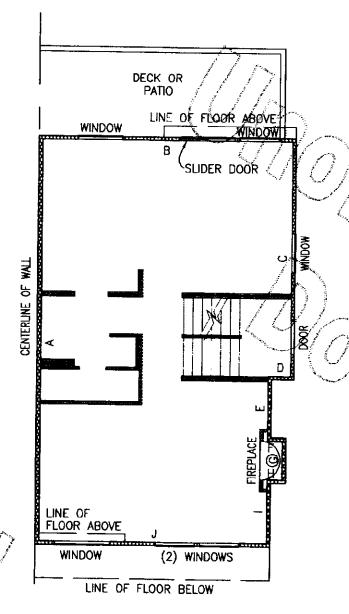

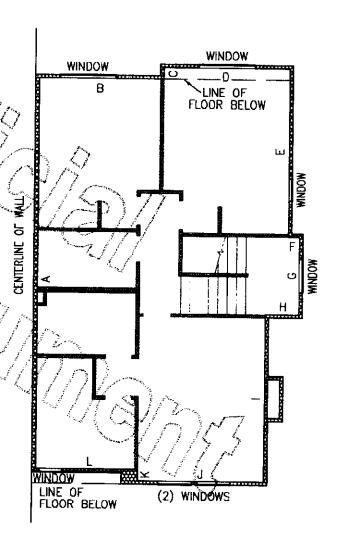


UNIT TYPE FAND F1 UNIT TYPE F AND

1" = 8'

BLDG. 12, UNIT 1, MIRROR IMAGE BLDG. 12, UNIT 4 UNIT TYPE F

BLDG. 12, UNIT 1, MIRROR IMAGE

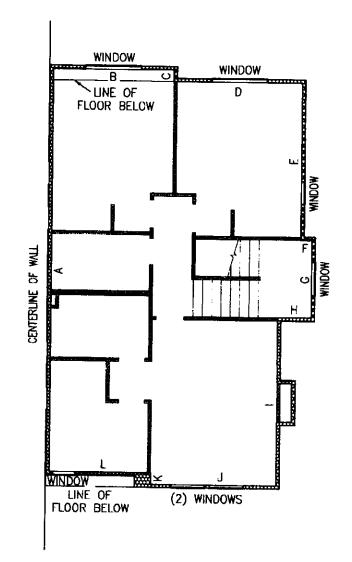


BLDG. 12, UNIT 1, MIRROR IMAGE BLDG. 12, UNIT 4

UNIT TYPE F1

SECOND FLOOR PLAN

1 = 8'

BLDG. 12, UNIT 4

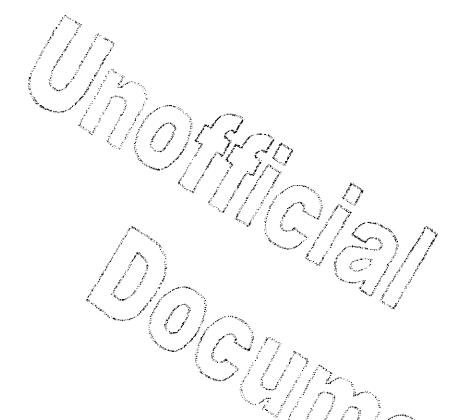

NOTES:

1. UNLESS OTHERWISE NOTED OR SHOWN HEREON, DIMENSIONS ARE ON THE INNER FACE OF THE OUTER WALL OF THE UNIT. INNER WALLS ARE SHOWN FOR LAYOUT PURPOSES ONLY.

2. UNIT LAYOUT IS FROM PLANS BY MILBRANDT ARCHITECTS, SHEETS U-1 THROUGH U-16, WITH REVISION DATE OF 11-19-97.

SEE SHEET 8 FOR UNIT DIMENSIONS AND CEILING HEIGHTS. DROP CEILING (D.C.) HEIGHTS ARE SHOWN ON UNIT LAYOUT SHEETS 4 THROUGH 7 OF 8.

JOB NO. 5903



Barghausen
Consulting Engineers, Inc.

Civil Engineering, Land Planning, Surveying, Environmental Services 18215 72nd Avenue South Kent, WA. 98032
Telephone: (425) 251-6222 Fax: (425) 251-8782

SW1/4, NE1/4 SEC. 22-24N-6E


SHEET 7 OF 8

## SUMMERHILL VILLAGE (PHASE 2) A CONDOMINIUM

A PORTION OF THE SOUTHWEST QUARTER OF THE NORTHEAST QUARTER SECTION 22, TOWNSHIP 24 NORTH, RANGE 6 EAST, WILLAMETTE MERIDIAN KING COUNTY, WASHINGTON

<u> </u>	Eritor I		51.005	DANIE S	/																	And the second s						CENING HEIGHT   F.F. ELEV.					
BUILDING NO.	NO.		FLOOR	UNIT DI A		S C	D	IE .	ΙΓ ······	G	Н	-	D.	ik)	11.	Maria Sa	N	10	P	O	IR	S	T AJ	U	V	w D					C.H. GA	<u>F.F. E</u> Arage i	
10	. 1		GARAGE FIRST				9.70		9.50	6.00	11 406	Secretary Sec.		12.40			7.50	4.90	7.50	2.60	33.50	~~ <b>~</b> ~							9.00	9	.50 40	06.88	407.38
											11.00	77					7.30	4.50	3.30	2.00	32.30		- (1) (1) (1) (1) (1) (1) (1) (1) (1) (1)								***		
	2		GARAGE SECOND	17.90 25.90			6.90				16.60 14:30		4.50	10.00 12.50		1	5.10	5.50	0.80	3.30	6.50	3.50	5.00	20.50	600	1.60	31.60	8.10 1	0.60	8.10 9	,50 .40	06,90	407.33 417.16
( • • • • • • • • • • • • • • • • • • •									1			1					- Mr [M.	3,30	0.00		0.00	, , <b>, , , , , , , , , , , , , , , , , </b>	5, 2, QV				-1.00			, ]			
			GARAGE SECOND				10.50 6,40		5.20 4.20	12.40	15.90		9.80	5.50	15.90													8.10	9.60	8.10 8.10	.50   40		407.36 417.16
				20.00					10.20			ا ما المعان	1.1.1.7.		100			1 2 2 2 2		****												06.90	407.16
				14.90						t6.40	15.70	5.50	8.90	2,10	9:60	2.00	12.30	7					2 2									06.90	
	5	C2	GARAGE	16.60	3.40	12.50	2.70	4.00	21.90	11.10	5.30	5.70		1. (1. 1. 1.) No. (1. 1. 1.)		***												\\\\\\\\\\\\\\\\\\\\\\\\\\\\\\\\\\\\\\		وانج	40 40	06.90	407.32
			SECOND				5.60				12.00		1.00	.A.50	2.00	11.90	1.50	11.00	27.40	34.00	1.60	8.50	0.50	5,10	3.50			10.00 1	0.60 8		353 S		417.12
	6	C1	GARACE				13.60			91, 7, 1			- X					3.00	10.00							7				ं र 🖢 9	40 40	06.88	
			FIRST	4.80	5.00	9.40	6.30	12.00	3,20	1:10	8.60	2.00	11.90	71.50	11.00	2/.30	33.30	2.60	3.30		ki Š							9.10	9.00	9.10		· · · · · · · · · · · · · · · · · · ·	407.28
	1		GARAGE FIRST	21.90	1 <u>3.60</u> 5.00					\1.10						07.40	77.00	2.50	7.70		, v											06.94	
			60000			12.5			<b>Y</b>						11.00	27.40	33.20	2.50	3.30					4		$\times \times$		3.00	9.00	9.00 23.2			407.44
	2		GARAGE SECOND	16.60 <sub>-</sub> 6.40	3.40 3.40			4.30 3.30	21.90	6.50	5.30 12.00	5.70 3.20	1.00	<b>8</b> .50	2.00	11.90	1.60	11 10	27.40	54.10	1.70	8.50	0.40	5.00	3.50				10.60				407.40 417.20
									i kan				<b></b>	4.4.4.		1 · · · · · · ·		12.22	ببب										\$ <del>\$\$</del> \$\$			- 3, 2 S.	
****			SECOND .	20.10 15.00					33.30	16.40	15.70	5.50	8.90	2.10	9.60	2.10	12.30				**************************************	******				****		8.10	9.60		.50 40		407.42 417.20
	4	В	CARAGE	18.80	15.70	21.30	10.50	2.50	5.20						<b>-</b>	\$ 3 A.			3.77								$\mathbb{Z}$			$\frac{1}{3}$			107.12
			SECOND	16.30						12.50				5.50	15.80							· · · · · ·		***					9.60 8				417.22
	5		GARAGE	17.90			6.90	2.60	5.90	3.50	16.50	5.40	4.60	10.00	202	<u> </u>								<u> </u>	C 0 0 X A			331	<u> </u>	2 3 9	40 10	06.94	407.42
منبنية	33		SECOND	25.80	11.30	2.00	11.30	2.00		6,00		3.80			2.00		5.20	5.60	0.80	3.40	6,50	3,50	5.00	0.50	6.10	1,60	31.80	8.10[1	10.60 8	8.10			417.22
	6		GARAGE	21.30		21.30			18.00							<b>X</b>				23.53				****						<del></del>	.50 40	<u>06.94</u>	407.44
			<u> </u>	,25,40	11.30	2.00	11.30	2.00	9.50	6.00	11.30	3,50	2.00	5.00	2.00	3,80	/.50		3.50				بربر دیکرد در د در در در در در در					9.00	9.00	9.00	~:45		به حکومکت محمد نده
12	1		GARAGE BASEMENT		21.90 21.70		0.70	8.60	2.00	6.90	0.70	2.30	20.40						444			<del>~~~~</del>						***			.40 40 .80 -	07.11	407.71
			FIRST	35.80	22,40	20.90	2.00	5.80		3.30			20.40						1	2.XX.Y				******* *********					9.00	3243	$\Sigma\Sigma\Sigma$		416.31
				34.70		<b>733</b> %			<b>]</b>	6.90		15,00	11,30	1.20	9.20						2.3.3.			<u> </u>				8.10		8.10			426.11
k.×.	2		GARAGE FIRST	36.00 40.00	15.30 15.30	33.20 37.50	5.20	2./0	10.30	225				X X		<b>1</b> 2200	\\\\\\\\\\\\\\\\\\\\\\\\\\\\\\\\\\\\\\	X			3557						44/3/ 33/3/	<del>₹</del>	9 00	<u> </u>	3.40 40	09.06	409.67 418.16
		533	SECOND	40.00	3.00	1.00	9.90	1.00	2.40	37.50	5.20	2.50	10.20		1.2.			N.				\.\ <del>\\\\\\\\\\\\\\\\\\\\\\\\\\\\\\\\\\</del>	$\sum_{i} \sum_{j=1}^{n} \sum_{i=1}^{n} \sum_{j=1}^{n} \sum_{j=1}^{n$					8.10		8.10			427.96
	3_	E	GARAGE	36.00	15.30	33.50	5.10	2.50	10.20		35%	183 X		1000	***	1000 1000				3	X X X		85°50 3000			<u> </u>				(	40 40	09.07	409.66
	$\times$		FIRST SECOND	39.90 40.00	15.40	37.40	5.20	2.50	10.20						/ 2445   1845   1	N. S.				X X X X								8 10	9.00	8 10 V		XX	418.17
	323		<u> </u>	. Z	2.32	1 2 2 2	12.0	1 2 2 2 2 2 2 2 2 2 2 2 2 2 2 2 2 2 2 2	13.23	2 22		77.00			1000				(VZ)			<b>*</b>						<del>\$</del> \$\$		23 1			
3		1111	DWOLMEINI	1 10.00	Z 1.70	เฉ.ดบ	1 21.70	D. 15.	****		$(A_1,A_2,A_3,A_4,A_4)$	1.1.57.22		1	.17.77 \	· · · · · ·	4 * 4 * <b>X</b> *.	1 7 7 7 7 7		トケイススト		X.V.X XX.V.X	\$25.57				**************************************		XXX	231 <del>1</del>	.80 💢	11.09 P	411.59
			FIRST SECOND	35.80	22.40	21.30	2.00	5.80	1.30	3.30 6.90	1.30	5.70	20.40	\$ 55	4533	4 <b>3777</b> 7	( X & .							XXXX									
$X(\mathcal{O}(\mathcal{O}))$			2028 Y	C(X,Y)	<b>38.78</b>	<b>X</b> 3060		$\mathbb{R}^{\mathbb{Z} \times \mathbb{Z}}$	1			1877A		7.5%		4							ZÝV.			(\$25) R	<u> </u>	XXX	XXXX	XXX	9898	\$\$X\\$X\\$	$\Sigma\Sigma$
14 \$3.525		とくさん	BASEMENT	787.17	37.63(2)	7777	11.20	1. 1. 1.	12 22	1333	3.70	10 Y Y T	11,20		1	<b>}</b>	1.40.	3.80	4.00	7 X X	T 39.50.	<b>1900 STATE</b>	7.5.77	30775			(X.CAX)			$\sim \sim 10^{-3}$			ZZXX,Y
	2	DΙ	GARAGE	21.30	9.70	21.30	9.70	2.00	0.50	600	11 30	CHO.	1 60	7.00	1 60	1 80	7.50	4.00	3503	2.60	3230						XZ	9.00		0 00 2	1.50 4	20.35	420.85
		2	GARAGE FIRST	25.30 22.22	, 1, JU	4,70	11.00	7.00	3.00	1 0.00	ران. دین	7.00	1.00	7.30		3.00	7,00	4.30	1.20°	3 2 3 2	, J. J. J.				نبنب		*****	3.00	2.001 2.001	9. VV () (			رورو <u>ي.</u> بينيه د
	100	72																										8 10 1	10.60	B. 10	7.30	20.37 \$\$\$\$\$	420.81 430.61
			CARACE	18 00	15 70	21 Vn	10.50	240	5 20			1	4			1	\$33.50		0.80			454		بذبيتي			17.	.223.1	35.42	$\mathcal{L}(\mathcal{M})$		20.37	
			SECOND	16.40	30.90	- 1.40	6.40	5.40	4.30	12.40	15.90	2.50	9.80	5.50	(j90		1.025										77.74	8 10	9.60] 8	ล 10 โ	::: <b>:::</b>	7778	430 61
	51	A	GARAGE	1.4	1. N. C. X	1.	de San	A	1.		محدميا	10						1		****	4			الخجد						والخيخ		20.37	420.81
				14.90	× 4.20-	Ì ∿5.40	9.00	1.50	33.30	16.40	15.60	5.50	9.20	1 2.00	9.60	. 2.00	12.00		<i>∤ /</i>	1. 18. 30	, (X	12.5	SECTO Marco	7 3 2 2 2 3 3 3 3 3 3 3 3 3 3 3 3 3 3 3				8.10	9.60	9.30 เ√	-3. LS		430.61
	1.6	€2`	-GARAGE	16.60	3.40	10.00	2.60	4.30	21.90	11.10	5.40	5.70		<b></b>			4	**************************************		,,(,,(,) <u>,,,,,,,,,,,,,,,,,,,,,,,,,,,,,,</u>	ئىنىنىڭ مەھىمە	7.4.		32.22				:534	- XX	19	1.50 42	20.36	420.78
			SECOND		· San Andrew		<b>}</b>		9.40		12.00			9.00	2.00	11.90	1.50	11.00	27.40	34.00	1.70	8.50	0.40	5.10			$\mathcal{L}(\mathcal{L})$						<b>3322</b>
	13	Ci	GARAGE FIRST	21.90	13.60	21,90	13.60 6.30	11.00	3.20		8.80				J-1.00	1320		1322		S. A.		23.72					XXX	$\sim \sim 1$	27.5 A.N	19	).50 I 42	20.36	ころてん
			14. 1. 1. 1. 1. 1. 1. 1. 1. 1. 1. 1. 1. 1.	14.7.5		1.	$\mathbf{k}$			1.633		$S_{i}(s,s)$			17170	41.4V	22,30	Z.0U	3. <u>20</u>	2			/ / / / / / / / / / / / / / / / / / /					$\langle x \rangle \langle x \rangle$	55.40	$\lambda \lambda $	5A 48X	<i>XXX</i> .	$\cdot$
	8	S.	BASEMENT	Sec. 13.	· · ·		<b>}</b>	1	41.40	9.30	4.00	2,40	2.40		كِذَمُهُمُ		<u>ئېنې</u>	نكنت							بممعد			9.00	9.00	9.00			411.07
G-J			GARAGE	- 9:40	19:00	9.40	19.00	12.77.77	<b></b>			<b>X</b>	<b>1</b> 4.43			1				14.524			14.3					· 🔨 🏄	55646	\$ 45 T	4(	09.6±	/ N = // N ×
	1 2		GARAGE	9.40	19.00	9.40	19.00				<b>***</b>					1	ئىنىنىي ئىزىنىل	1							منت دریخ مند مند		17.53	: : : : : : : : : : : : : : : : : : :		7. A.	! 40	09.6±	1.56
		****		W.		C	D		F	G	11	7 7 7	J ····	K	L	M	N	0	I P	0	R	Ś	T	U. V.	V ( ( ( ( ( ( ( ( ( ( ( ( ( ( ( ( ( ( (	W	X X X Y						
J 1/4			mare 3 <sub>a</sub>	, e. y Pr.			بند سيكون						-					<del></del>				<del></del>				<del></del>				N.,			,314

NOTE: THE FINISHED FLOOR FIFVATION SHOWN ABOVE FOR CARACE "G-1" ARE BASED ON DESIGN." GARAGE "G-1" WAS NOT BUILT AS OF THE DATE THESE ORAWINGS WERE PREPARED.

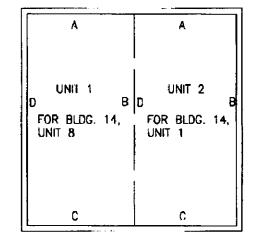

GARAGE UNIT

FLOOR PLAN



M.C.H. = MASTER BEOROOM CEILING HEIGHT G.C.H. = GARAGE CEILING HEIGHT LIC.H. = LIVING ROOM CEILING HEIGHT B.C.H. = BEDROOM CEILING HEIGHT

JOB\_NO. 5903

Barghausen Consulting Engineers, Inc.
Civil Engineering, Lond Planning, Surveying, Environmental Services
18215 72nd Avenue South Kent, WA. 98032 lelephone: (425) 251-6222 Fax: (425) 251-8782

SW1/4, NE1/4 SEC. 22-24N-6E

SHEET 8 OF 8