PORTION OF THE SOUTHWEST QUARTER OF THE NORTHEAST QUARTER SECTION 22/TOWNSHIP 24 NORTH, RANGE 6 EAST, WILLAMETTE MERIDIAN KING COUNTY, WASHINGTON

LEGAL DESCRIPTION

(TOTAL PROPERTY)

THAT PORTION OF THE NORTH HALF DE THE SOUTHWEST QUARTER OF THE NORTHEAST QUARTER OF SECTION 22, TOWNSHIP 24 NORTH, RANGE 6 EAST, WILLAMETTE MERIDIAN, IN KING COUNTY, WASHINGTON, LYING WESTERLY OF THE WESTERLY LINE OF ISSAQUAH-FALL CITY ROAD AS CONVEYED TO KING COUNTY BY INSTRUMENTS RECORDED UNDER REC. NOS. 2721716, 8009230742, AND 8410180377;

except any portion thereof lying easterly of the westerly warding of a king county road being a strip of land 100 feet in width with THE CENTER BEING THE CENTERLINE OF ISSAQUAH-FALL CITY ROAD AS ESTABLISHED BY JANG COUNTY SURVEY NUMBER 22-24-6-13 AND BY DEED RE-CORDED UNDER RECORDING NUMBER 9809041411, SAID CENTERLINE BEGINNING AT THE SOUTHWEST CORNER OF SECTION 22, TOWNSHIP 24 NORTH, RANGE

6 EAST, WILLAMETTE MERIDIAN, RECORDS OF KING COUNTY;
THENCE SOUTH 88"24"57" EAST A DISTANCE OF 476.30 FEET ALONG THE SOUTH LINE OF SAID SECTION 22;
THENCE NORTH 54"34"34" EAST A DISTANCE OF 2,389.54 FEET TO THE POINT OF BEGINNING AND THE BEGINNING OF A 720.00 FOOT RADIUS TANGENT

CURVE TO THE LEFT;

THENCE ALONG THE ARC OF SAID 720.00 FOOT RADIUS CURVE THROUGH A CENTRAL ANGLE OF 38'43'08" AN ARC DISTANCE OF 488.56 FEET; THENCE NORTH 15'51'26" EAST, A DISTANCE OF 869.58 FEET TO THE BEGINNING OF A 1,538.00 FOOT RADIUS TANGENT CURVE TO THE LEFT;

THENCE ALONG THE ARC OF SAID 1,536.00 FOOT RADIUS CURVE THROUGH A CENTRAL ANGLE OF 33'43'18" AN ARC DISTANCE OF 904.02 FEET; THENCE NORTH 49"34"44" EAST, A DISTANCE OF 401.62 FEET TO THE INTERSECTION OF ISSAQUAH-PINE LAKE ROAD AND THE TERMINUS OF THIS CENTER-LINE DESCRIPTION:

AND EXCEPT THAT PORTION LYING SOUTHEASTERLY OF THE ARC OF A CIRCLE HAVING A RADIUS OF 25 FEET BEING TANGENT TO A LINE 50 FEET NORTHERLY AND PARALLEL TO SAID CENTERLINE OF ISSAQUAH-FALL CITY ROAD AND TANGENT TO A LINE 42 FEET WESTERLY OF AND PARALLEL TO THE CENTERLINE OF

TOGETHER WITH THAT PORTION OF THE SOUTH HALF OF THE SOUTHWEST QUARTER OF THE NORTHEAST QUARTER OF SECTION 22, TOWNSHIP 24 NORTH, RANGE 6 EAST, W.M., LYING WESTERLY OF THE WESTERLY LINE OF THE ISSAQUAH—FALL CITY ROAD AS CONVEYED TO KING COUNTY BY INSTRUMENTS RECORDED UNDER RECORDING NOS. 2721715/AND/8209200697, AND WESTERLY OF THE WESTERLY LINE OF COUNTY ROAD CONVEYED TO KING COUNTY BY DEED RECORDED UNDER RECORDING NO 9803201399;

EXCEPT THAT PORTION THEREOF LYING EASTERLY AND SOUTHERLY OF THE FOLLOWING DESCRIBED LINE: BEGINNING AT THE SOUTHWEST EQRNER OF SAIO SUBPRISION;

THENCE SOUTH 88'19'16" EAST, ALONG THE SOUTH LINE OF SAID SUBDIVISION 132.85 FEET TO THE TRUE POINT OF BEGINNING OF THIS EXCEPTION; THENCE NORTH 01'36'43" EAST, PARALLEL TO THE WEST LINE OF SAID SUBDIVISION, 96.42 FEET;
THENCE NORTH 88'35'31" EAST TO THE WESTERLY RIGHT OF WAY MARGIN OF SAID ISSAQUAH-FALL CITY ROAD AND THE TERMINUS OF SAID LINE;

SITUATE IN THE COUNTY OF KING, STATE OF WASHINGTON:

LEGAL DESCRIPTION

THAT PORTION OF THE NORTH HALF OF THE SOUTHWEST QUARTER OF THE NORTHEAST QUARTER OF SECTION 22, TOWNSHIP 24 NORTH, RANGE 6 EAST, W.M. IN KING COUNTY, WASHINGTON, LYING WESTERLY OF THE WESTERLY LINE OF ISSAQUAH-FALL CITY ROAD AS CONVEYED TO KING COUNTY BY INSTRUMENTS RECORDED UNDER RECORDING NUMBERS 2721716, 8609230742, AND 8410180377, AND WESTERLY OF THE WEST LINE OF ISSAQUAH-FALL CITY ROAD AS ESTAB-LISHED BY KING COUNTY SURVEY NUMBER 22-24-6-13 AND BY DEED RECORDED UNDER RECORDING NOMBER 8869041411, DESCRIBED AS FOLLOWS:

COMMENCING AT THE SOUTHEAST CORNER OF THE ABOVE DESCRIBED PARCEL; THENCE NORTH 88'10'44' WEST ALONG THE SOUTH LINE THEREOF, 194,56 FEET TO THE SOUTHWEST CORNER OF SUMMERHILL VILLAGE (PHASE 1), AS RE-CORDED IN VOLUME 157 OF CONDOMINUMS, AT PAGES 62-70, RECORDS OF KING COUNTY, WASHINGTON; THENCE NORTHERLY ALONG THE WEST LINE OF SAID SUMMERHILL VILLAGE (PHASE 1), THE FOLLOWING COURSES:

NORTH 13"51"27" WEST, 97.69 FEET;

THENCE NORTH 71°13'30" EAST, 70.00 FEET TO THE TRUE POINT OF BEGINNING;

THENCE NORTH 2711'37" EAST, 132.22 FEET;

HENCE NORTH 4710 37 EASI, 132.22 FEET;
THENCE NORTH 43740'28" EAST, 241.20 FEET;
THENCE NORTH 05'43'28" EAST, 65.00 FEET;
THENCE NORTH 65'46'38" EAST, 166.61 FEET;
THENCE NORTH 03'58'53" WEST, 98.11 FEET TO THE NORTHWEST CORNER OF SAID SUMMERHIEL VIELACE (PHASE 1) SAID POINT ALSO BEING ON THE NORTH LINE OF THE ABOVE REFERENCED SUBDIVISION;

THENCE NORTH 88'00'36" WEST ALONG THE NORTH LINE OF SAID NORTH HALF OF THE SOUTHWEST QUARTER OF THE NORTHEAST QUARTER, 344.24 FEET; THENCE SOUTH 01"59'24" WEST, 145.00 FEET;

THENCE SOUTH 88'42'43" EAST, 95.70 FEET;

THENCE SOUTH 01"59"24" WEST, 25.15 FEET;

THENCE SOUTH 07"19"02" WEST, 80.60 FEET:

THENCE SOUTH 30'26'14" WEST, 171.93 FEET; THENCE SOUTH 09'20'52" WEST, 84.70 FEET;

THENCE SOUTH 14"32"29" WEST, 52.66 FEET TO THE POINT OF BEGINNING.

LEGAL DESCRIPTION (SUBSEQUENT PHASE PROPERTY)

THAT PORTION OF THE NORTH HALF OF THE SOUTHWEST QUARTER OF THE NORTHEAST QUARTER OF SECTION 22, TOWNSHIP 24 NORTH, RANGE 6 FAST, W.M. In King County, Washington, Lying Westerly of the Westerly Line of Issaquah—fall City Road as conveyed to King County by instruments RECORDED UNDER RECORDING NUMBERS 2721716, 8009230742, AND 8410180377, AND WESTERLY OF THE WEST LINE OF ISSAGUAN-FALL CITY ROAD AS ESTAB-LISHED BY KING COUNTY SURVEY NUMBER 22-24-6-13 AND BY DEED RECORDED UNDER RECORDING NUMBER 9809041411;

EXCEPT THAT PORTION THEREOF LYING EASTERLY OF THE FOLLOWING DESCRIBED LINE: COMMENCING AT THE SOUTHEAST CORNER OF THE ABOVE DESCRIBED PARCEL;

THENCE NORTH 88'10'44" WEST ALONG THE SOUTH LINE THEREOF, 194.56 FEET TO THE TRUE POINT OF BEGINNING:

THENCE NORTH 13"51"27" WEST, 97.69 FEET; THENCE NORTH 71"13"30" EAST, 70.00 FEET;

THENCE NORTH 14'32'29" EAST, 52.66 FEET;

THENCE NORTH 09"20"52" EAST, 84.70 FEET; THENCE NORTH 30"26"14" EAST, 171.93 FEET

THENCE NORTH 07'19'02" EAST, 80.60 FEET;

THENCE NORTH 01°59'24" EAST, 25.15 FEET; THENCE NORTH 88°42'43" WEST, 95.70 FEET;

THENCE NORTH 01°59'24" WEST, 145.00 FEET TO THE NORTH LINE OF SAID PARCEL AT A POINT THAT IS NORTH 88'00'36" EAST FROM THE NORTHEAST

CORNER THEREOF, AND THE TERMINUS OF THIS LINE.

TOGETHER WITH THAT PORTION OF THE SOUTH HALF OF THE SOUTHWEST QUARTER OF THE NORTHEAST QUARTER OF SECTION 22, TOWNSHIP 24 NORTH. range 6 East, w.m., lying westerly of the westerly line of the issaguah—fall city road as conveyed to king county by instruments re— CORDED UNDER RECORDING NOS. 2721716 AND 8209200697, AND WESTERLY OF THE WESTERLY LINE OF COUNTY ROAD CONVEYED TO KING COUNTY BY DEED RECORDED UNDER RECORDING NO. 9803201399;

EXCEPT THAT PORTION THEREOF LYING EASTERLY AND SOUTHERLY OF THE FOLLOWING DESCRIBED LINE:

BEGINNING AT THE SOUTHWEST CORNER OF SAID SUBDIVISION;

THENCE SOUTH 88"19"16" EAST, ALONG THE SOUTH LINE OF SAID SUBDIVISION 132.85 FEET TO THE TRUE POINT OF BEGINNING OF THIS EXCEPTION; THENCE NORTH 01'36'43" EAST, PARALLEL TO THE WEST LINE OF SAID SUBDIVISION, 96.42 FEET;

THENCE NORTH 88"35"31" EAST TO THE WESTERLY RIGHT OF WAY MARGIN OF SAID ISSAQUAH-FALL CITY ROAD AND THE TERMINUS OF SAID LINE:

DEDICATION

KNOW ALL MEN BY THESE PRESENTS, THAT WE, THE UNDERSIGNED OWNERS IN FEE SIMPLE OF THE REAL PROPERTY DESCRIBED HEREIN, HEREBY DEDICATE THE REAL PROPERTY DESCRIBED IN THIS SURVEY MAP AND THESE PLANS FOR CONDOMINIUM PURPOSES. THE DRIVES, WALKS, STREETS, GROUNDS AND OTHER AREAS DESCRIBED HEREIN ARE NOT DEDICATED TO THE PUBLIC, BUT ARE PRESERVED FOR THE EXCLUSIVE USE AND BENEFIT OF THE UNIT CHAIRERS, AS PART OF THE COMMON ELEMENTS, TO THE EXTENT AND IN THE MANNER SET FORTH IN THE DECLARATION. WE, THE UNDERSIGNED OWNERS OF THE PROPERTY, HEREBY CERTIFY THAT ALL STRUCTURAL COMPONENTS AND MECHANICAL SYSTEMS OF ALL BUILDINGS CONTAINING OR COMPRISING UNITS HEREBY CREATED ARE SUBSTANTIALLY COMPLETED. THE SURVEY MAP AND THESE PLANS OR ANY PORTION THEREOF SHALL BE RESTRICTED BY THE TERMS OF THE DECLARATION FILED THE 12 DAY OF 0, 199 9, RECORDS OF KING COUNTY, WASHINGTON UNDER RECORDING NO. 1999 1026 000857

IN WITNESS THEREOF WE HAVE SET OUR HANDS AND SEAL.

MACLEAN SOUTH, L.L.C., A WASHINGTON LIMITED LIABILITY COMPANY

BY: POLYGON NORTHWEST COMPANY,

A WASHINGTON GENERAL PARTNERSHIP ITS: MANAGER

BY: BRENTVIEW, INC., A WASHINGTON CORPORATION ITS: MANAGING PARTNER

MACLEAN TOWNHOMES, L.L.C., A WASHINGTON LIMITED LIABILITY COMPANY

POLYGON NORTHWEST COMPANY,

A WASHINGTON GENERAL PARTNERSHIP

BY: BRENTVIEW, INC., A WASHINGTON CORPORATION ITS: MANAGING PARTNER

E. H.C. Was BY: Bric H.G. Wells

IIS: Authorized And

ACKNOWLEDGMENTS

STATE OF WASHINGTON COUNTY OF KING

CERTIFY THAT I KNOW OR HAVE SATISFACTORY EVIDENCE THAT ETC H. LUCKS IS THE PERSON WHO APPEARED BEFORE ME, AND SAID PERSON ACKNOWLEDGED THAT (S)HE SIGNED THIS INSTRUMENT, ON OATH STATED (S)HE MAS AUTHORIZED TO EXECUTE THE INSTRUMENT AND ACKNOWLEDGED IT AS THE AUTHORIZED AGENT 'of brentview, Nice the Managing Partner of Polygon Northwest Company, the Manager of Maclean TOWRITIONES, L.C., A MASHINGTON LIMITED THABILITY COMPANY, AND ACKNOWLEDGED THAT (S)HE IS AUTHORIZED TO SIGN THIS INSTRUMENT AND ACKNOWLEDGED IT—TO BE THE FREE AND VOLUNTARY ACT OF SAID LIMITED LIABILITY COMPANY FOR THE USES AND PURPOSES MENTIONED IN THE INSTRUMENT.

Nomen NOTARY PUBLIC IN AND FOR THE STATE OF WASHINGTON RESIDING AT THE STATE OF WASHINGTON

PRINTED NAME LOCALLY & Chieman

STATE OF WASHINGTON

I CERTIFY THAT I KNOW OR HAVE SATISFACTORY ENDENCE THAT GIVE HE LANDS IS THE PERSON WHO APPEARED BEFORE ME, AND SAID PERSON ACKNOWLEDGED THAT (S)HE SIGNED THIS INSTRUMENT, ON OATH STATED (S)HE WAS AUTHORIZED TO EXECUTE THE INSTRUMENT AND ACKNOWLEDGED IT AS THE AUTHORIZED AGENT OF BRENTVIEW, INC., THE MANAGING PARTNER OF POLYGON NORTHWEST COMPANY, THE MANAGER OF MACLEAN SOUTH, L.L.C., A WASHINGTON LIMITED LIABILITY COMPANY, AND ACKNOWLEDGED THAT (S)HE IS AUTHORIZED TO SIGN THIS INSTRUMENT AND ACKNOWLEDGED IT TO BE THE FREE AND VOLUNTARY ACT OF SAID LIMITED LIA-BILITY COMPANY FOR THE USES AND PURPOSES MENTIONED IN THE INSTRUMENT.

DATED THIS 18 DAY OF OCCUPENT, 1999.

MOTARY PUBLIC IN AND FOR THE STATE OF WASHINGTON RESIDING AT THE STATE OF WASHINGTON PRINTED NAME AND R.CADING



LAND SURVEYOR'S CERTIFICATE

I HEREBY CERTIFY THAT THESE PLANS FOR SUMMERHILL VILLAGE PHASE 2, A CONDOMINIUM, ARE BASED UPON AN ACTUAL SURVEY OF THE PROPERTY DESCRIBED HEREIN AND THAT THE COURSES AND DISTANCES ARE SHOWN ACCURATELY THEREON AND THAT THESE PLANS ACCURATELY DEPICT THE LOCATION AND DIMENSIONS OF THE UNITS AS-BUILT. THESE PLANS ARE PER THE BASIC REQUIREMENTS PURSUANT TO RCW 64.34.262. AND THAT ALL HORIZONTAL and vertical boundaries of the units are substantially completed in accordance with said plans.

LAND SURVEYOR'S VERIFICATION

S.S.

DENNIS J. SALTYS, BEING FIRST ON OATH DULY SWORN, STATES THAT HE IS THE REGISTERED PROFESSIONAL LAND SURVEYOR SIGNING THE ABOVE CERTIFICATE, THAT HE HAS EXAMINED THESE PLANS AND SURVEY MAP, AND BELIEVES/THE CERTIFICATE TO BE A TRUE STATEMENT.

NOTARY PUBLIC IN AND FOR THE STATE OF WASHINGTON RESIDING AT THE STATE OF WASHINGTON PRINTED NAME OF THE STATE OF THE STATE OF WASHINGTON PRINTED NAME OF THE STATE OF T COMMISSION EXPIRES



APPROVAL

KING COUNTY ASSESSOR

RECORDING NUMBER

EXAMINED AND APPROVED THIS 25^t

DEPUTY KING COUNTY ASSESSOR

RECORDING CERTIFICATE

DEPARTMENT OF RECORDS AND ELECTIONS

99/026000 856

JOB NO. 5903




Barghausen Consulting Engineers, Inc.

Civil Engineering, Land Planning, Surveying, Environmental Services 18215 72nd Avenue South Kent, WA. 98032 Telephone: (425) 251-6222 Fax: (425) 251-8782


SW1/4, NE1/4 SEC. 22-24N-6E

SHEET 1 OF 8

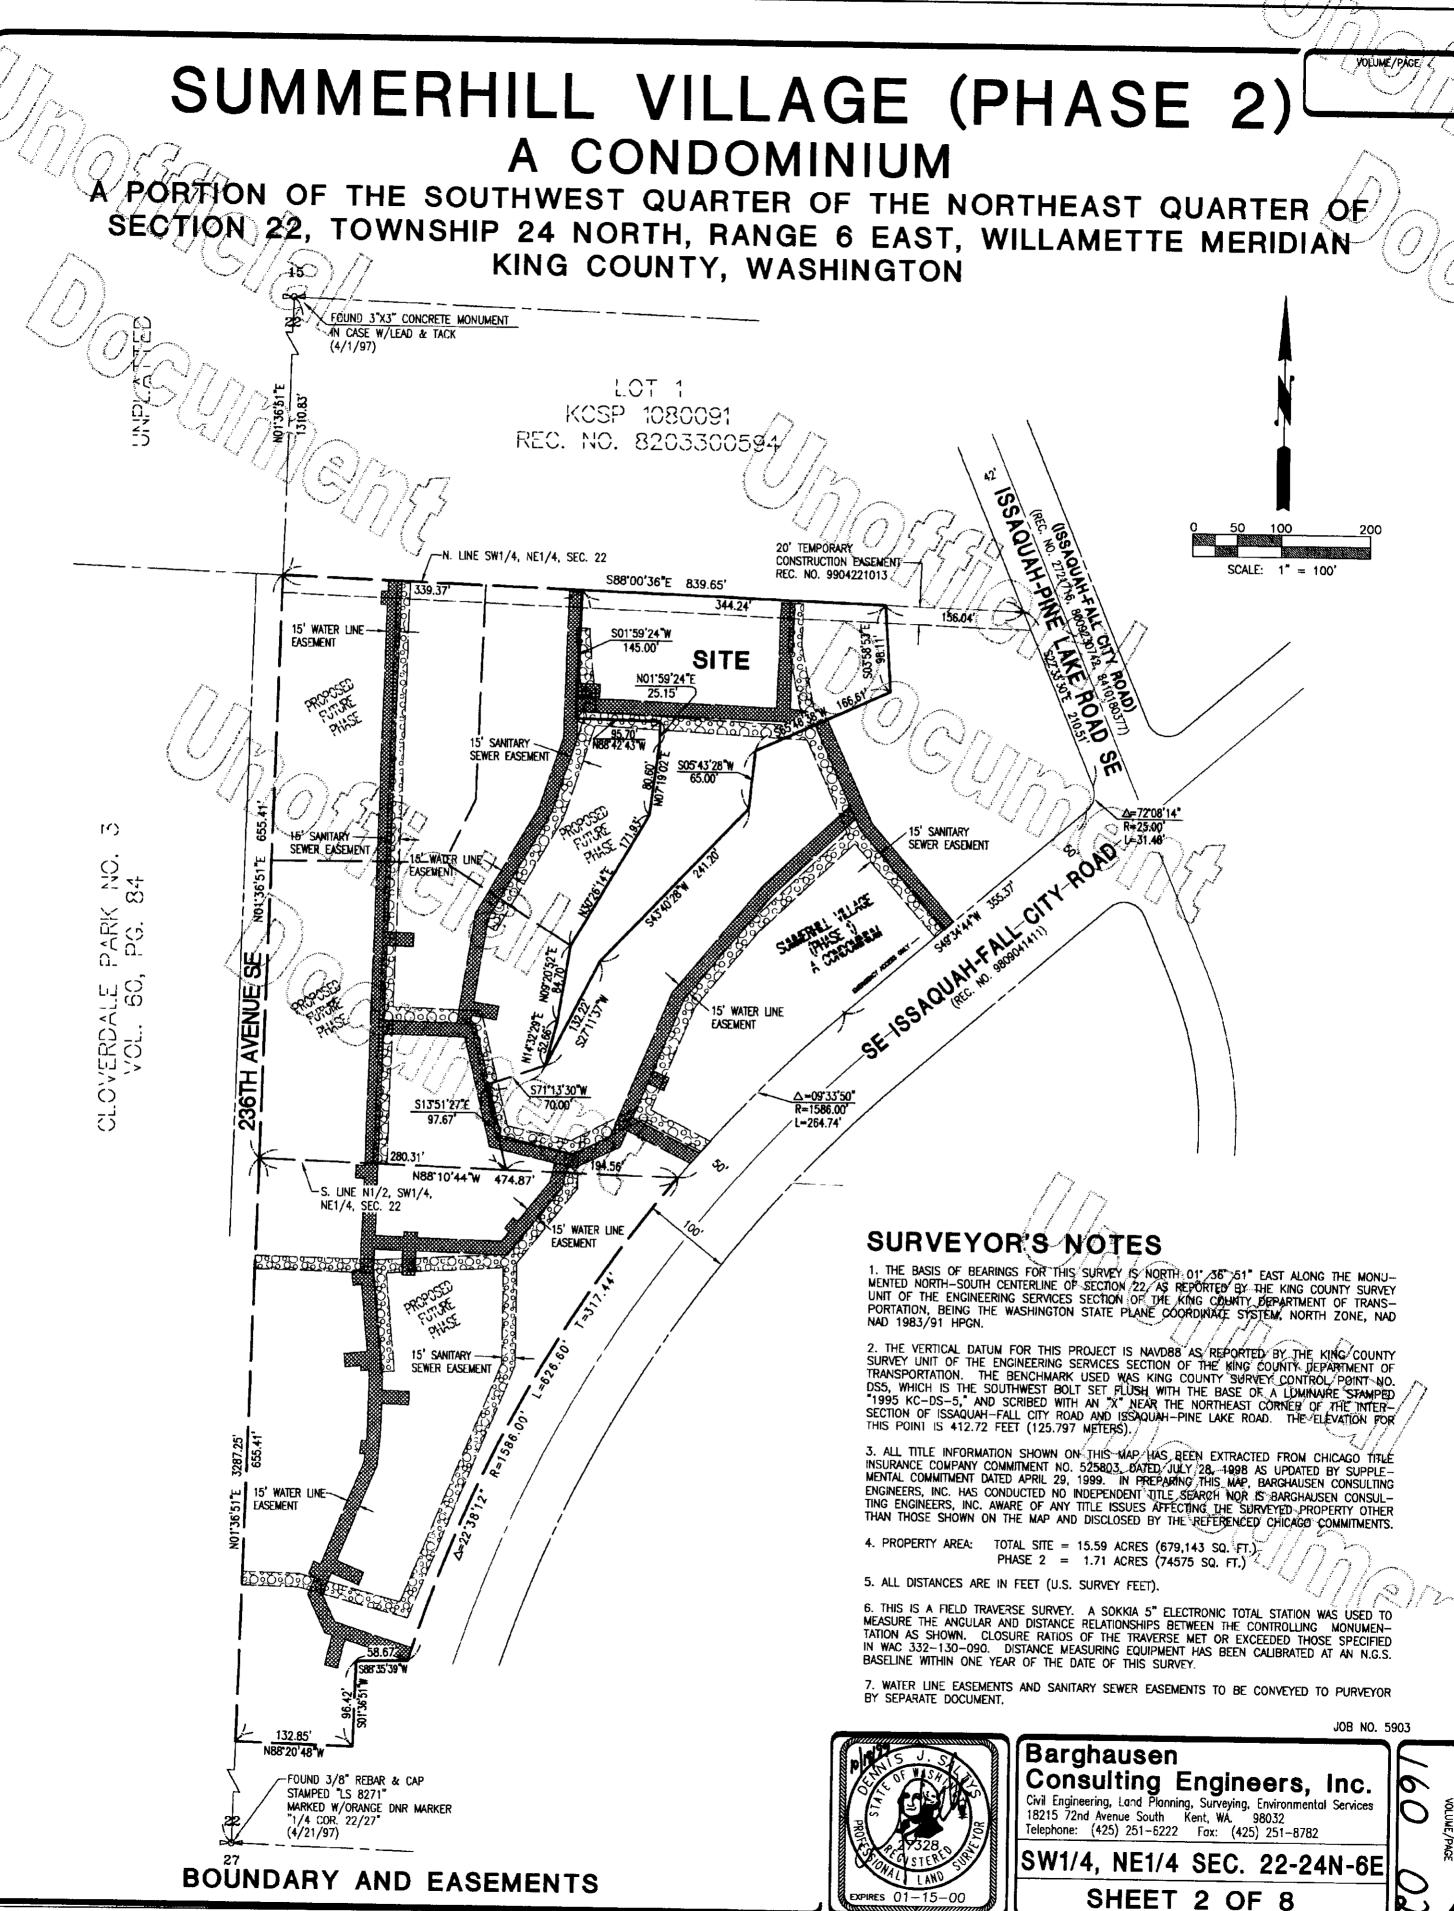

ibPDF - www.fastio.com

ne: 10/18/1999 08:14 Scale: 1-100 Joanne Xrefs.

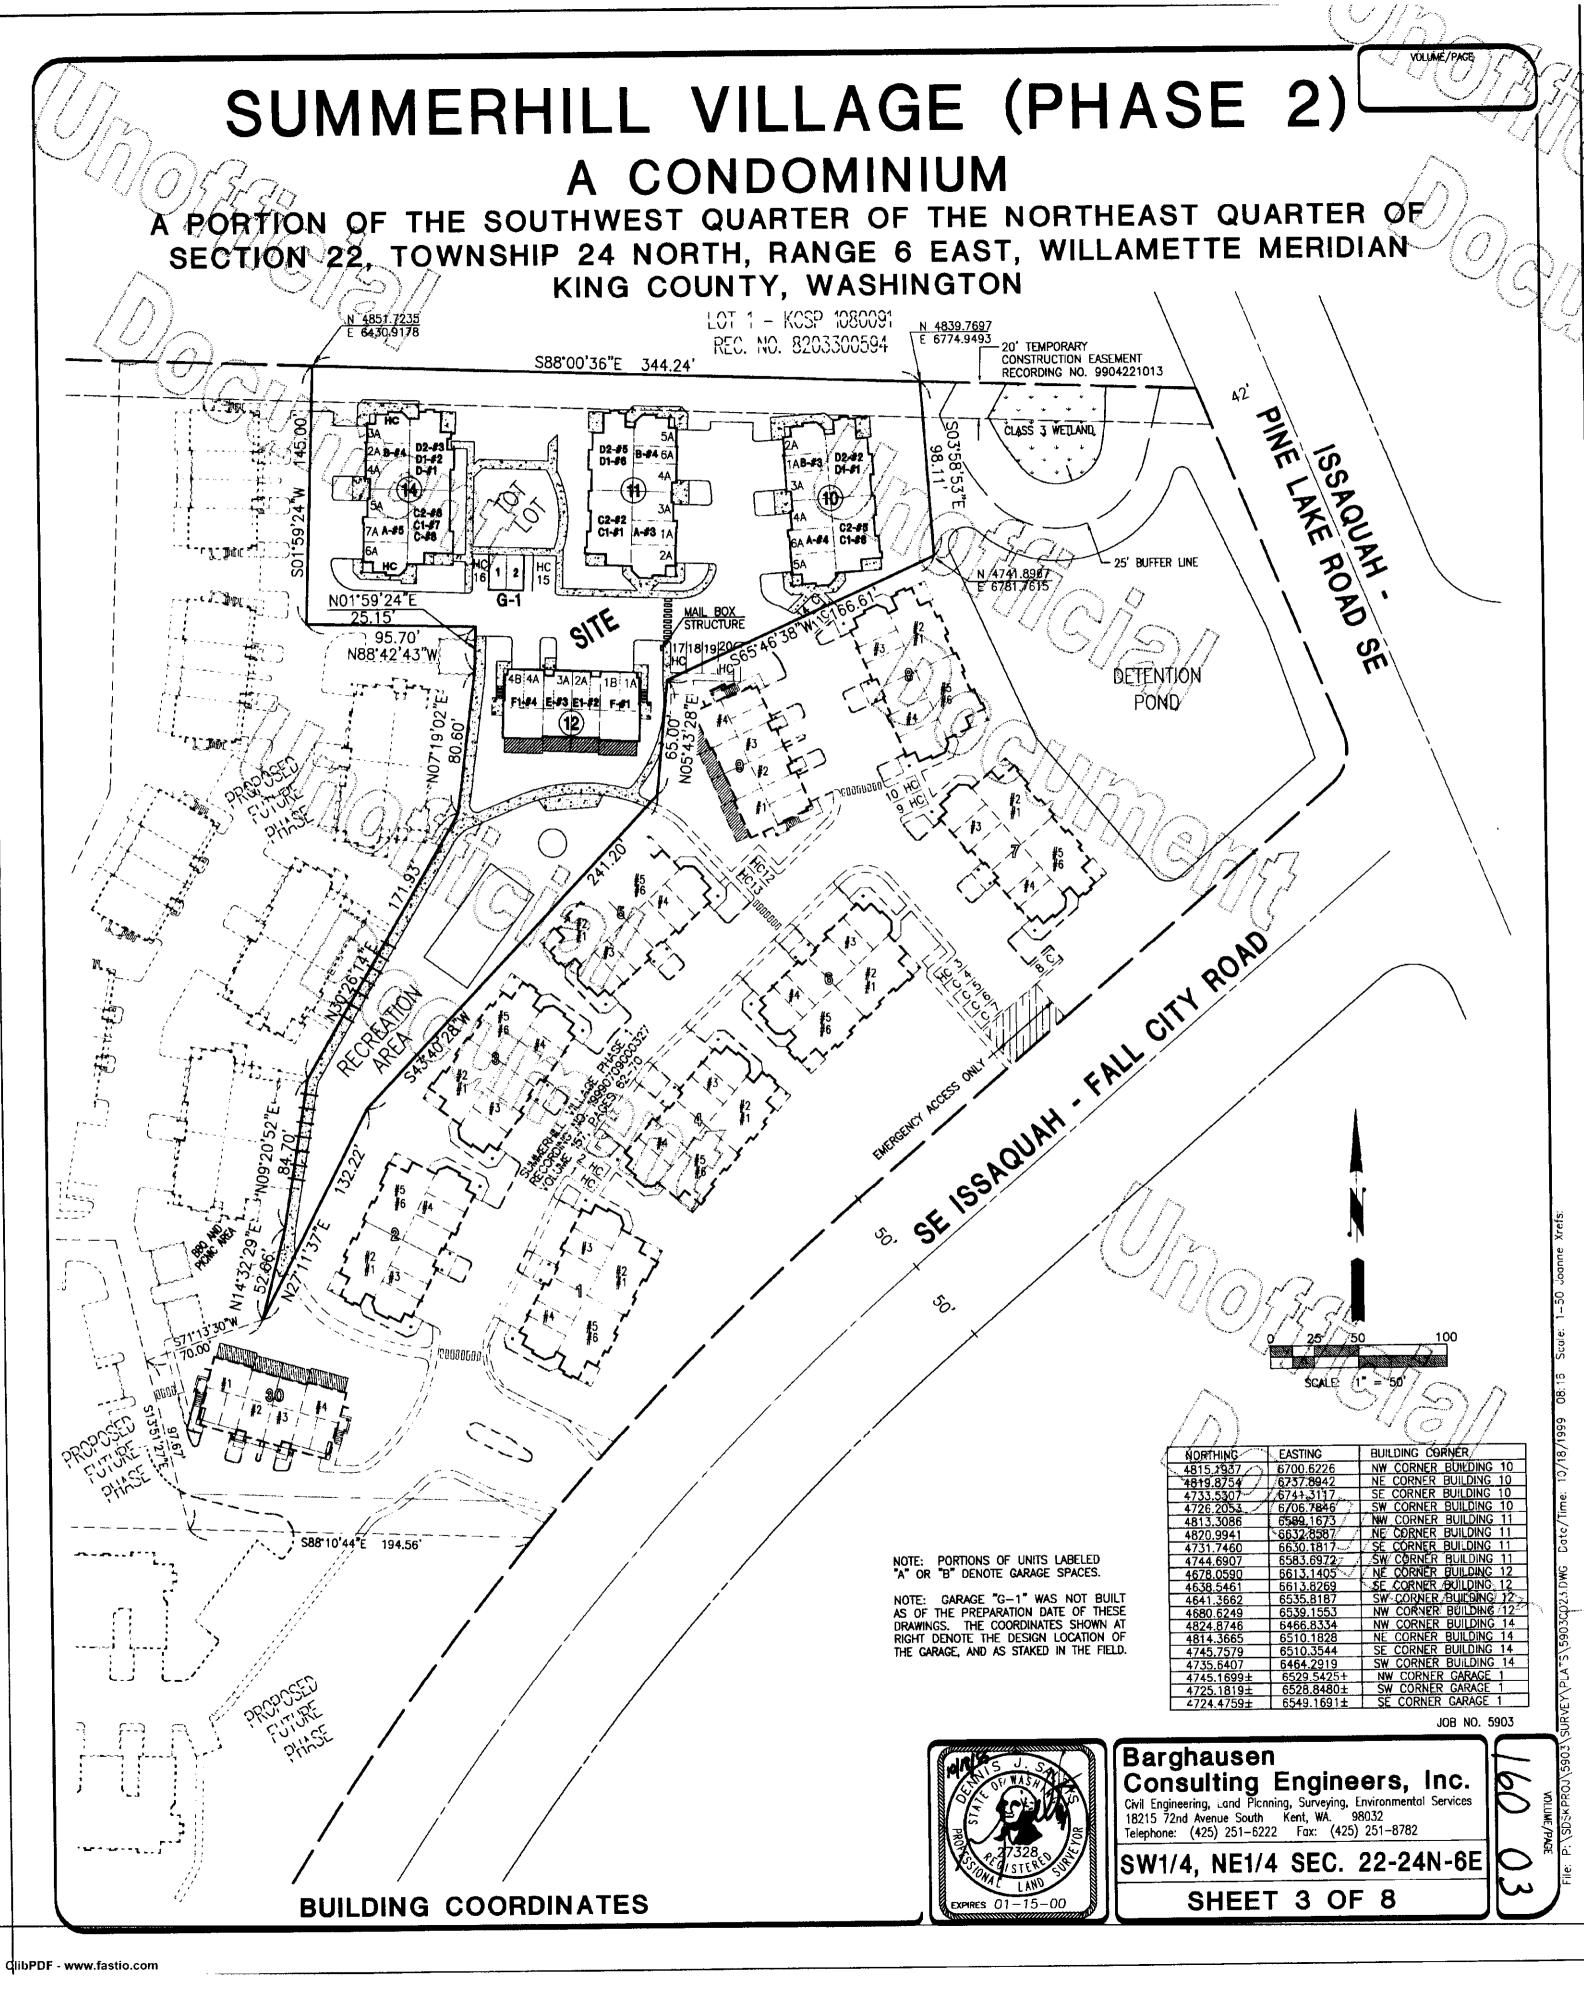


PORTION OF THE SOUTHWEST QUARTER OF THE NORTHEAST QUARTER OF SÉCTIÓN 22, TOWNSHIP 24 NORTH, RANGE 6 EAST, WILLAMETTE MERIDIAN KING COUNTY, WASHINGTON



BLDG. 10, UNIT 6, MIRROR IMAGE

BLDG. 11, UNIT 1 BLDG. 14, UNIT 7, MIRROR IMAGE

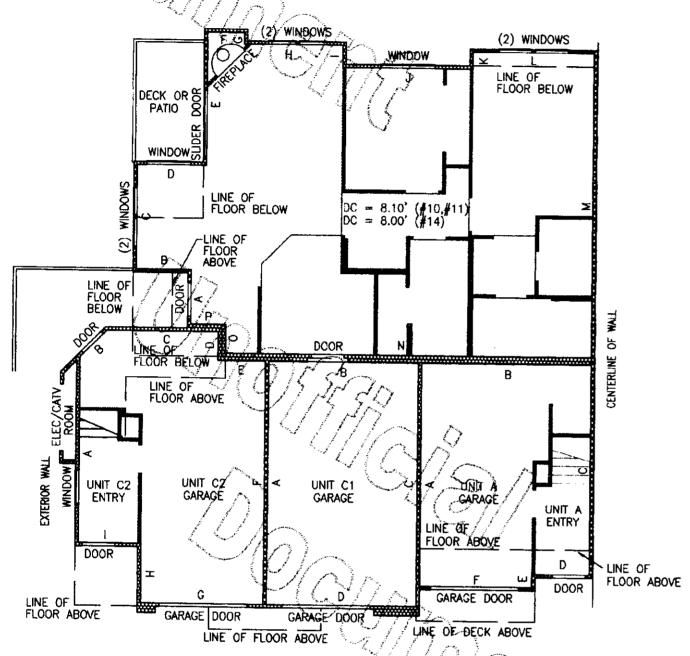

GARAGES FOR UNIT


UNIT A BLDG. 10, UNIT 4, MIRROR IMAGE

BLDG. 14, UNIT 4, MIRROR IMAGE

BLDG. 11, UNIT 3


UNIT C1 BLDG. 10, UNIT 6, MIRROR IMAGE BLDG. 11, UNIT 1 BLDG. 14, UNIT 7, MIRROR IMAGE

UNII UZ BLDG. 10, UNIT 5, MIRROR IMAGE BLDG. 11, UNIT 2 BLDG. 14, UNIT 5, MIRROR IMAGE

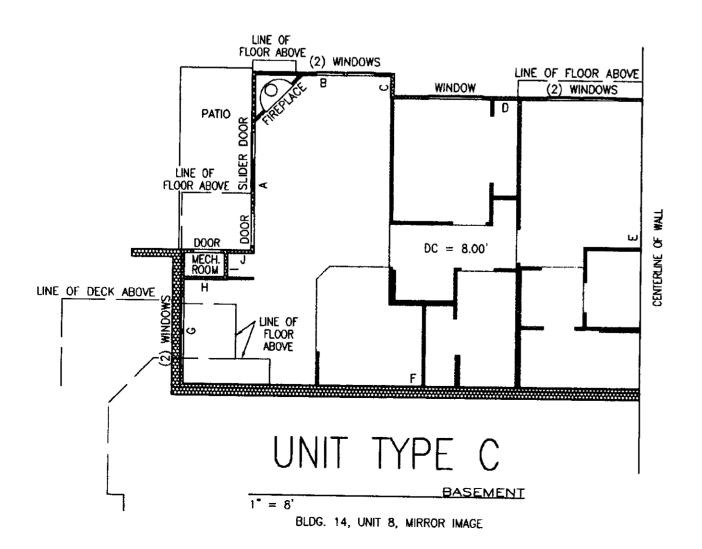

UNIT TYPE C2

BLDG. 10, UNIT 5, MIRROR IMAGE BLDG. 11, UNIT 2 BLDG. 14, UNIT 5, MIRROR IMAGE

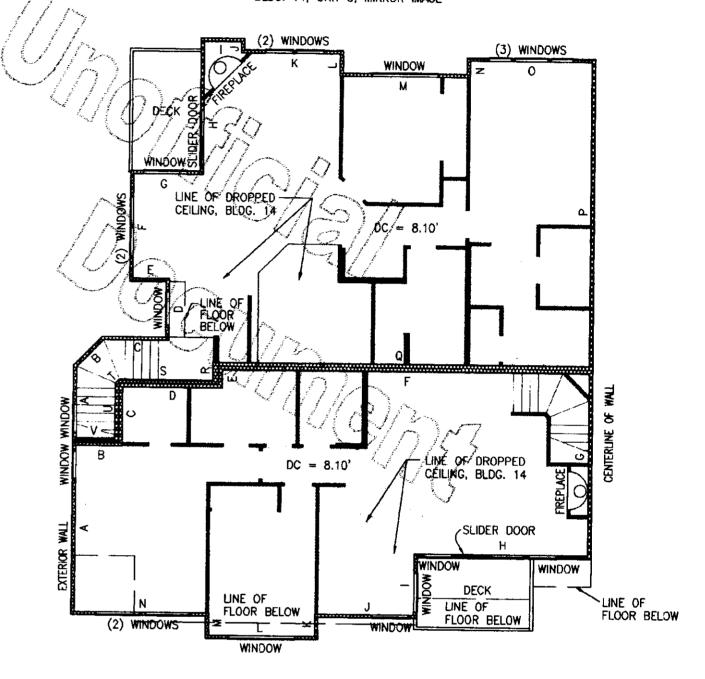

SECOND FLOOR PLAN

BLDG. 10/ UNIT 4 MIRROR IMAGE BLDG. 14, UNIT 3 BLDG. 14, UNIT 6 MIRROR IMAGE



1. UNLESS OTHERWISE NOTED OR SHOWN HEREON, DIMENSIONS ARE ON THE INNER FACE OF THE OUTER WALL OF THE UNIT. INNER WALLS ARE SHOWN FOR LAYOUT PURPOSES ONLY.

2. UNIT LAYOUT IS FROM PLANS BY MILBRANDT ARCHITECTS, SHEETS U-1 THROUGH U-16, WITH REVISION DATE OF 11-19-97.

SEE SHEET 8 FOR UNIT DIMENSIONS AND CEILING HEIGHTS. DROP CEILING (D.C.) HEIGHTS ARE SHOWN ON UNIT LAYOUT SHEETS 4 THROUGH 7 OF 8.

JOB NO. 5903



Barghausen Consulting Engineers, Inc.

Civil Engineering, Land Planning, Surveying, Environmental Services 18215 72nd Avenue South Kent, WA. 98032 Telephone: (425) 251-6222 Fax: (425) 251-8782

SW1/4, NE1/4 SEC. 22-24N-6E

SHEET 4 OF 8

SUMMERHILL VILLAGE (PHASE 2)


A CONDOMINIUM

PORTION OF THE SOUTHWEST QUARTER OF THE NORTHEAST QUARTER OF SECTION 22, TOWNSHIP 24 NORTH, RANGE 6 EAST, WILLAMETTE MERIDIAN KING COUNTY, WASHINGTON



BLDG. 10, UNIT 1, MIRROR IMAGE BLDG. 11, UNIT 6

BLDG. 14, UNIT 1, MIRROR IMAGE

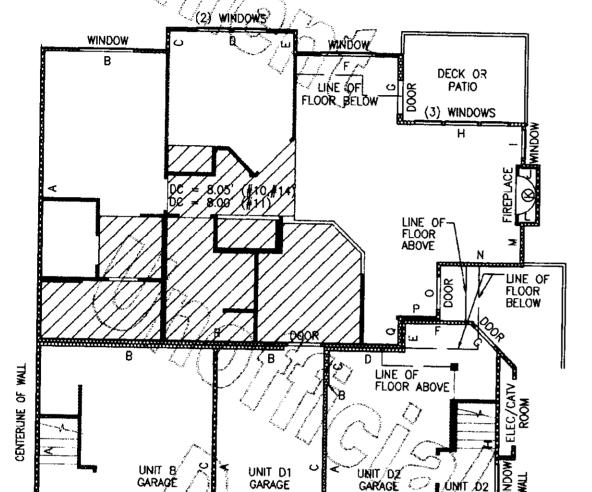

GARAGES FOR UNIT TYPES B. DIE

LINE OF FLOOR ABOVE

GARAGE DOOR

GARAGE


LINE OF FLOOR ABOVE

GARAGE DOOR

LINE OF DECK ABOVE


DOOR

UNIT B UNIT D1 BLDG. 10, UNIT 3, MIRROR IMAGE BLDG. 10, UNIT 1, MIRROR IMAGE BLDG. 10, UNIT 2, MIRROR IMAGE BLDG. 11, UNIT 5 BLDG. 11, UNIT 4 BLDG. 11, UNIT 6 BLDG. 14, UNIT 3, MIRROR IMAGE BLDG. 14, UNIT 1, MIRROR !MAGE BLDG. 14, UNIT 2, MIRROR IMAGE

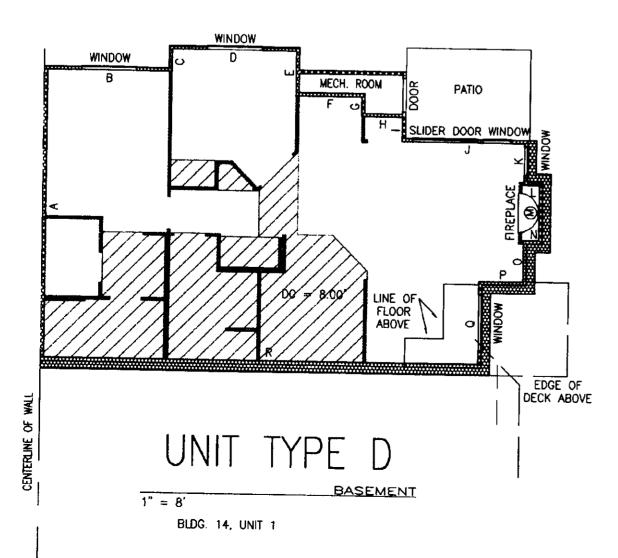

UNIT TYPE D2

BLDG. 10, UNIT 2, MIRROR IMAGE BLDG. 11, UNIT 5 BLDG. 14, UNIT 2, MIRROR IMAGE

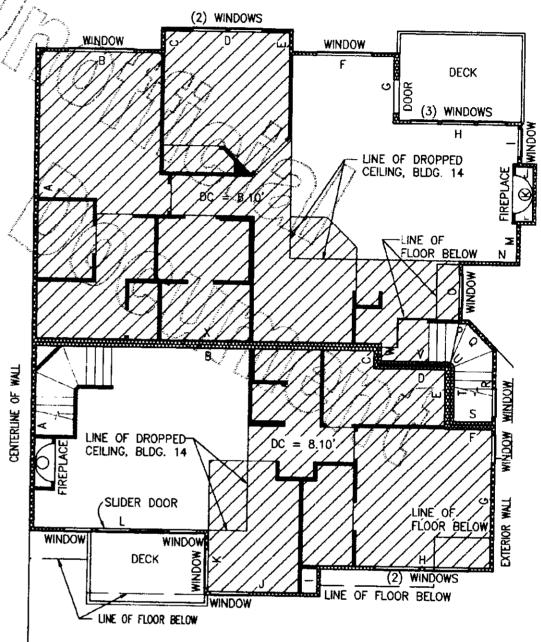

SECOND FLOOR PLAN

BLDG. 10, UNIT 3, MIRROR IMAGE BLDG. 14, UNIT 3, MIRROR IMAGE



1" = 8'

1. UNLESS OTHERWISE NOTED OR SHOWN HEREON, DIMENSIONS ARE ON THE INNER FACE OF THE OUTER WALL OF THE UNIT. INNER WALLS ARE SHOWN FOR LAYOUT PURPOSES ONLY.

2. UNIT LAYOUT IS FROM PLANS BY MILBRANDT ARCHITECTS, SHEETS U-1 THROUGH U-16, WITH REVISION DATE OF 11-19-97.

SEE SHEET 8 FOR UNIT DIMENSIONS AND CEILING HEIGHTS. DROP CEILING (D.C.) HEIGHTS ARE SHOWN ON UNIT LAYOUT SHEETS 4 THROUGH 7 OF 8.

JOB NO. 5903




Barghausen Consulting Engineers, Inc.


Civil Engineering, Land Planning, Surveying, Environmental Services 18215 72nd Avenue South Kent, WA. 98032 Telephone: (425) 251-6222 Fax: (425) 251-8782

SW1/4, NE1/4 SEC. 22-24N-6E SHEET 5 OF 8

F - www.fastio.com

A PORTION OF THE SOUTHWEST QUARTER OF THE NORTHEAST QUARTER OF SECTION 22, TOWNSHIP 24 NORTH, RANGE 6 EAST, WILLAMETTE MERIDIAN KING COUNTY, WASHINGTON

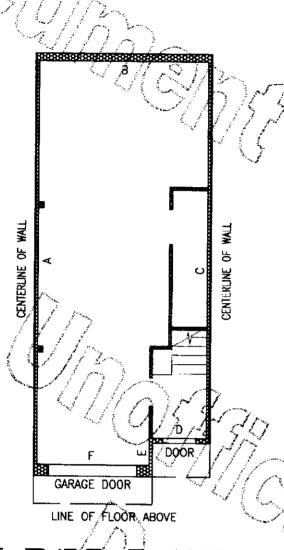

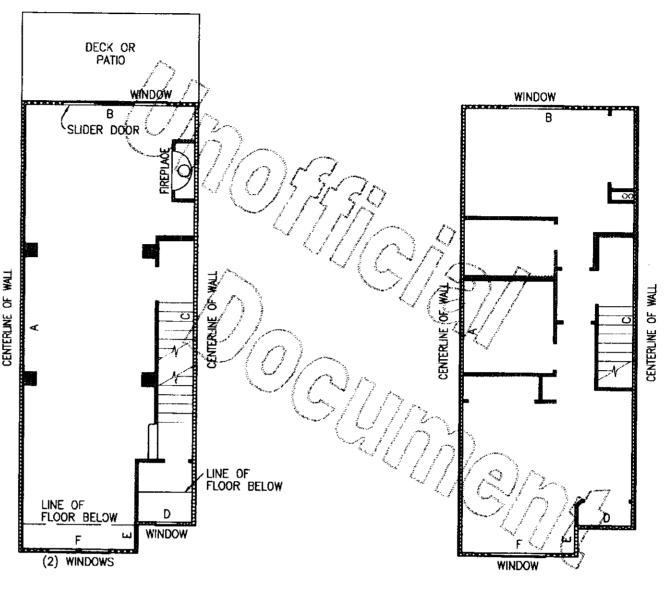

UNIT TYPE E AND E1

ROR JMAGE

BLDG. 12, UNIT 2, MIRROR MAGE BLDG. 12, UNIT 3 UNIT TYPE E AND E1


FIRST FLOOR PLAN

BLDG. 12, UNIT 2, MIRROR IMAGE BLDG. 12, UNIT 3

UNIT TYPE E

SECOND FLOOR PLAN


BLDG. 12, UNIT 3

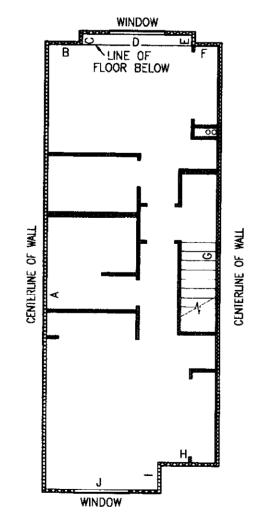

UNIT TYPE E1

SECOND FLOOR PLAN

BLDG. 12, UNIT 2, MIRROR IMAGE

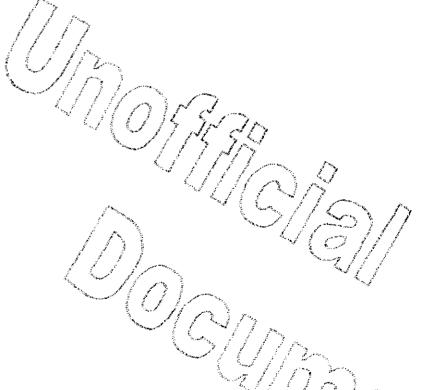

NOTES:

1. UNLESS OTHERWISE NOTED OR SHOWN HEREON, DIMENSIONS ARE ON THE INNER FACE OF THE OUTER WALL OF THE UNIT. INNER WALLS ARE SHOWN FOR LAYOUT PURPOSES ONLY.

2. UNIT LAYOUT IS FROM PLANS BY MILBRANDT ARCHITECTS, SHEETS U-1 THROUGH U-16, WITH REVISION DATE OF 11-19-97.

SEE SHEET 8 FOR UNIT DIMENSIONS AND CEILING HEIGHTS. DROP CEILING (D.C.) HEIGHTS ARE SHOWN ON UNIT LAYOUT SHEETS 4 THROUGH 7 OF 8.

JOB NO. 5903



Barghausen Consulting Engineers, Inc.


Civil Engineering, Land Planning, Surveying, Environmental Services 18215 72nd Avenue South Kent, WA. 98032
Telephone: (425) 251-6222 Fax: (425) 251-8782


SW1/4, NE1/4 SEC. 22-24N-6E


SHEET 6 OF 8

160 06

PORTION OF THE SOUTHWEST QUARTER OF THE NORTHEAST QUARTER OF SECTION 22, TOWNSHIP 24 NORTH, RANGE 6 EAST, WILLAMETTE MERIDIAN KING COUNTY, WASHINGTON

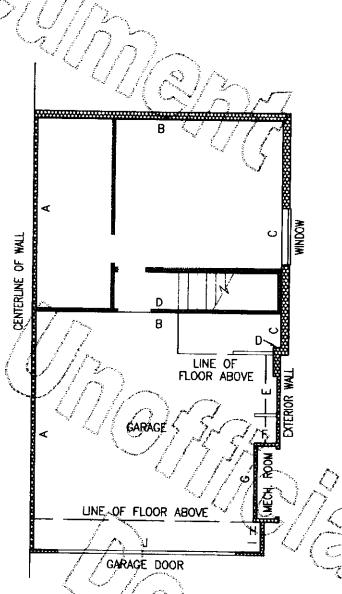

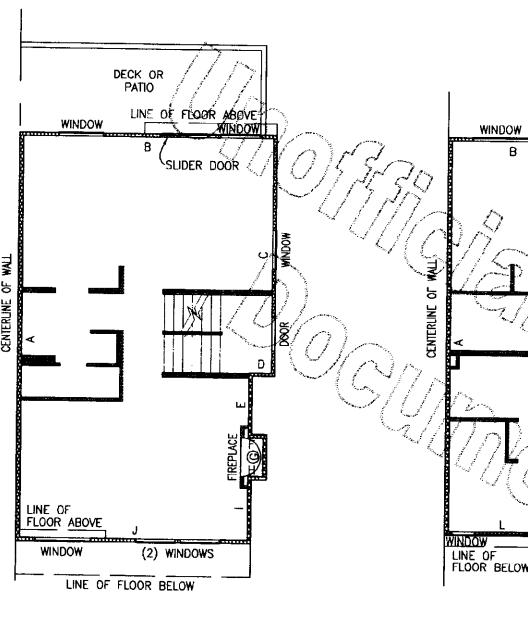


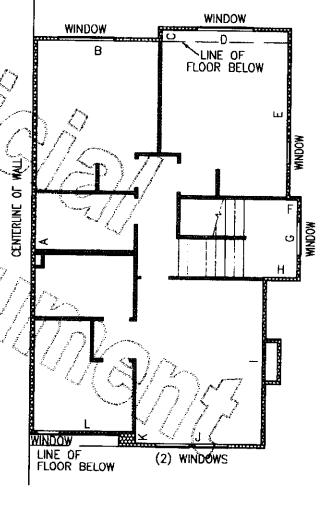


FIRST FLOOR PLAN

BLDG. 12, UNIT 1, MIRROR IMAGE BLDG. 12, UNIT 4

BLDG. 12, UNIT 1, MIRROR IMAGE

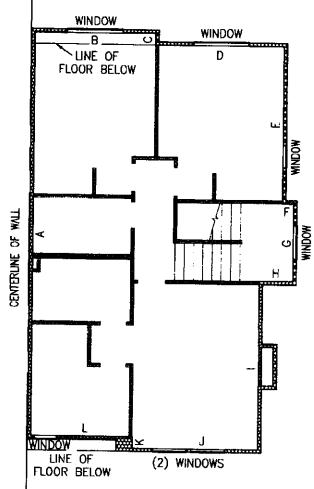

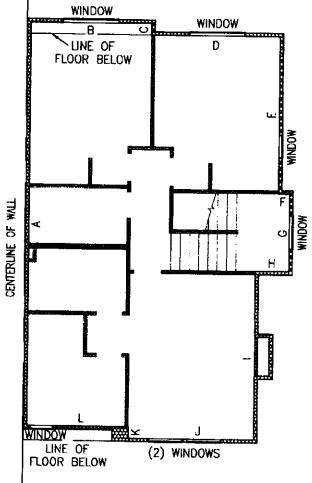


BLDG. 12, UNIT 1, MIRROR IMAGE. BLDG. 12, UNIT 4

UNIT TYPE F1

SECOND FLOOR PLAN

BLDG. 12, UNIT 4

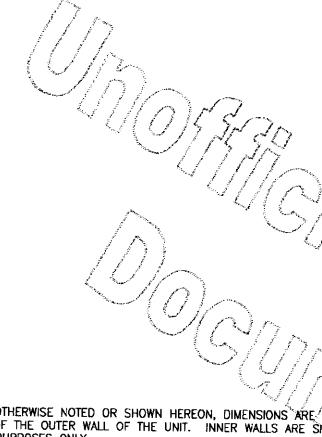


NOTES:

1. UNLESS OTHERWISE NOTED OR SHOWN HEREON, DIMENSIONS ARE ON THE INNER FACE OF THE OUTER WALL OF THE UNIT. INNER WALLS ARE SHOWN FOR LAYOUT PURPOSES ONLY.

2. UNIT LAYOUT IS FROM PLANS BY MILBRANDT ARCHITECTS, SHEETS U-1 THROUGH U-16, WITH REVISION DATE OF 11-19-97.

SEE SHEET 8 FOR UNIT DIMENSIONS AND CEILING HEIGHTS. DROP CEILING (D.C.) HEIGHTS ARE SHOWN ON UNIT LAYOUT SHEETS 4 THROUGH 7 OF 8.

JOB NO. 5903

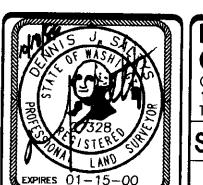

Barghausen Consulting Engineers, Inc.

Civil Engineering, Land Planning, Surveying, Environmental Services 18215 72nd Avenue South Kent, WA. 98032 Telephone: (425) 251-6222 Fax: (425) 251-8782

SW1/4, NE1/4 SEC. 22-24N-6E

SHEET 7 OF 8

ClibPDF - www.fastio.com

SUMMERHILL VILLAGE (PHASE 2) A CONDOMINIUM

A PORTION OF THE SOUTHWEST QUARTER OF THE NORTHEAST QUARTER SECTION 22, TOWNSHIP 24 NORTH, RANGE 6 EAST, WILLAMETTE MERIDIAN KING COUNTY, WASHINGTON

Court DAIGE CHAIL LUNG L. 51.00	LINIT DAIFNEONIC			A STATE OF THE PARTY OF THE PAR			
BUILDING UNIT UNIT FLOO NO. NO. TYPE	A B C D	E F G H	ı (li karı	IL M	O P Q R S	X W V UL TI	CELLING HEIGHT F.F. ELEV. MAC.H.L. C.M. B.C.H. G.C.H. GARAGE UNIT
10 1 D1 GAR/ FIRS	E 21.30 9.70 21.30 9.70 25.80 11.30 2.00 11.30			- 7.50	4.90 3.50 2.60 32.50		9.00 9.00 406.88 9.00 9.00 407.38
2 D2 GAR/	E 17.90 0.10 3.00 6.90	2.60 5.90 3.50 16.60	5.40 4.50 10.00				8.10 10.60 8.10 9.50 406.90 407.33
SEC(5.50 0.80 3.30 6.50	3.50 5.00 0.50 6.00 1.60 3	160 417.16
	E 18.90 15.70 21.30 10.50 ND 16.40 30.80 1.40 6.40		750 080 580	15.00			9.50 406.88 407.36 8.10 9.60 8.10 417.16
4 A GAR							
SECO			5.50 8.90 2.10	9.60, 2.00 12.30			9.60 9.60 9.60 9.60 406.90 417.12
	SE 16.60 3.40 12.50 2.70						9.40 406.90 407.32
SECO			3.20 1.00 A.50	2.00 11.90 1.50	11.00 27.40 34.00 1.60	8.50 0.50 5.10 3.50	10.00 10.60 8.10 417.12
6 C1 GAR/ FIRS	E 21.90 13.60 21.90 13.60 4.80 5.00 9.40 6.30	12.00 3,20 1:10 8.60	2.00 11.90 /1.50	11.00 27.30 33.30	2.60 3.30		9.10 9.00 9.10 406.88
11 1 C1 GARA							9.50 406.94
FIRS	4.90 5,00 9.40 6.30				2.50 3.30		9.00 9.00 9.00 107.44
2 C2 GARV			5.70 3.20 1.00 8.50	2.00 11.90 1.50	11.10 27.40 54.10 1.70	8.50 0.40 5.00 3.50	9.50 406.95 407.40 10.00 10.60 8.10 417.20
3 A GAR/	E 20.10 15.40 18.80 5.30						9.50 406.92 407.42
SEC	VD 15.00 4.20 5.20 9.10	1,40 33,30 16.40 15.70	5.50 8.90 2.10	9.60 2.10 12.30			8.10 9.60 9.30 417.20
4 B CARV	SE 18.80 15.70 21.30 10.50 ND 16.30 30.80 1.40 6.40	2.50 5.20 5.45 4.20 12.50 15.80	2 50 9 70 5 50	15.80			9.50 406.93 407.42 8.10 9.60 8.10 417.22
5 D2 GAR/			5.40 4.60 10.00				9.40 106.94 407.42
	ND 25.80 11.30 2.00 11.30	2.00 9.60 6.00 11.40			5.60 0.80 3.40 6.50	3.50 5.00 0.50 6.10 1.60 3	
6 D1 GAR	E 21.30 9.70 21.30 9.70						9.50 406.94 407.44
rins - Cirks	25.40 11.30 2.00 11.30			2.00 3.80 7.50	4.90 3.50 2.60 32.40		9.00 9.00 9.00
	IENT 16.80 21.70 16.80 21.70						8.40 407.11 407.71 7.80 407.71
FIRST SECO	35.80 22,40 20.90 2.00 ID 34.70 11.10 1.10 11.20	5.80 1.30 3.30 1.30 15.00 1.10 6.90 3.00		9.20			9.00 416.31 8.10 8.10 426.11
2 E1 CARA							8.40 409.06 409.67
FIRS	40.00 15.30 37.50 5.20 40.00 3.00 1.00 9.90	4 00 0 40 77 00 0 00	2.50 10.20				9.00 418.15 8.10 8.10 427.96
3 E GARA	E 36.00 15.30 33.50 5.10	2.50 10.20					8.40 409.07 409.66
FIRST	39.90 15.40 37.40 5.20 ID 40.00 15.40 37.50 5.20	2.50 10.20					9.00 418.17 8.10 427.97
6 4 F1 GARA	E 20.70 21.90 3.00 0.60	8.70 2.00 6.90 0.70	2.20 20.40				8,30 411.09
BASE FIRS	(ENTE 16.80 21.70 16.80 21.70	- N 1 (N. 17 47 47 47 4 18 4 47 18 18 4 6 6 6 6 1	さくさん サインス へんさいさん	\$\\\\\\\\\\\\\\\\\\\\\\\\\\\\\\\\\\\\\	Niziran Naziri da Najara kan kan kan kan kan kan kan kan kan ka	36000000000000000000000000000000000000	7.759 (5.50) (6.50) (6.50) (7.80) (7.80) (7.80) (411.59)
XXXXXXXXXXXXXXXXXXXXXXXXXXXXXXXXXXXXXX	(D) 36.80 10.90 1.00 11.60	5.80 1.30 3.30 1.30 14.00 1.00 6.90 3.00	14.90 11.30 1.20	9.20			9 10 420.19 8 10 8 10 429.99
14 1 D BASE	ENT 26.20 11.20 2.00 11.20	4.00 5.90 1.80 3.70	2.20 11.20 3.80	1.40 4.90 1.40	3.80 4.00 7.40 39.50 6		9.00 9.00 9.00 411.01
	E 10170 070 0170 070						CONTRACTOR AND A CONTRACTOR OF THE CONTRACTOR
7 DO CARA	F 17.90 0.10 73.00 6.00	7.00 5.00 7.40 18.50	5.40 4.50 10.00	/ 1.00 J.80 7.50/	4.90 3.30 4.00 32.30		9.00 9.00 9.00 420.35 9.50 420.37 420.81 1.60 8.10 10.60 8.10 430.61 9.50 420.37 420.81 9.50 420.37 420.81 9.50 420.37 420.81 9.50 420.37 420.81
SECC	₹D 25.80 11.30 (2.00 11.30	2.00 9.50 6.00 11.40	3.80 1.60 4.90	1.50 3.80 5.20	5.60 0.80 3,40 6.40	3,50 5.00 0.40 6.10 1.60 3	1.60 8.10 10.60 8.10 430.61
4 B CARA	E 18.90 15.70 21.30 10.50	2.40 5.20					9.50 420.37 420.81
SECU SECU	0 16.40 30.90 1.40 6.40	3.40 4.30 12.40 15.90	2.50 9.80 5.50	10.90%			430.61
	10 1 17.30 1° 7.20°1 'O.70 1 3.00	1 1.00 1.000 1.0.10 1.0.00	J.JU J.ZU A.UU	1~3.00.1 2.00 (12.00)			' ' ' ' O. O. O. O. O. O.
8 C2 GAR	E 16.60 3.40 10.00 2.60	4.30 21.90 11.10 5.40	5.70				9.50 420.36 420.78
SEC	ND 5.80 \3.40 6.50 5.60	3.30 9.40 6.30 12.00	3,30 1,00 - 9.00	2.00 11.90 1.50	11.00 27.40 34.00 1.70	8.50 0.40 5.10 3.50	
E1 GAR	GE 21.90 13.60 21.90 13.60 4.90 5.00 9.40 6.30	11.80 3.20 0.90 8.80	2.00 11.90 1.50	11.00 27.40 33.30	2.60 3.20		9.00 9.00 9.00 420.86
PROMOST 8 / IC I BASE	/ENTT16.10-1 12:20 \ 2.00 23.10	26.20 41.40 9.30 4.00	2.40 2.40				9.00 9.00 9.00 411.07
G-1 1 GAR/							409.6±
							409.6±
		F G 11		I M N		S T U V W X	
			<u> </u>	1 54 1 174 1	V II W IN	<u> </u>	

UNIT 2 UNII 1 FOR BLDG. 14, FOR BLDG. 14, UNIT 8 UNIT 1


GARAGE UNIT

FLOOR PLANT

NOTE: THE FINISHED FLOOR FI FVATION SHOWN ABOVE FOR CARACLE "G 1" ARE BASED ON DESIGN: GARAGE "G-1" WAS NOT BUILT AS OF THE DATE THESE DRAWINGS WERE PREPARED.

M.C.H. = MASTER BEDROOM CEILING HEIGHT G.C.H. = GARAGE CEILING HEIGHT LIC.H. = LIVING ROOM CEILING HEIGHT B.C.H. = BEDROOM CEILING HEIGHT

JOB NO. 5903

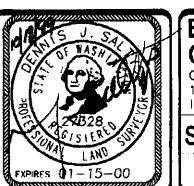

Barghausen Consulting Engineers, Inc. Civil Engineering, Lond Planning, Surveying, Environmental Services 18215 72nd Avertue South Kent, WA. 98032 lelephone: (425) 251-6222 Fax: (425) 251-8782

SW1/4, NE1/4 SEC. 22-24N-6E SHEET 8 OF 8