



# THE JUNIPER, A CONDOMINIUM

IN THE SE 1/4, NE 1/4 OF SECTION 28, T. 24 N., R. 42 E., WM.

NW JUNIPER STREET

3RD AVE. N.W.

PLAN VIEW WITH AS-BUILT DIMENSIONS

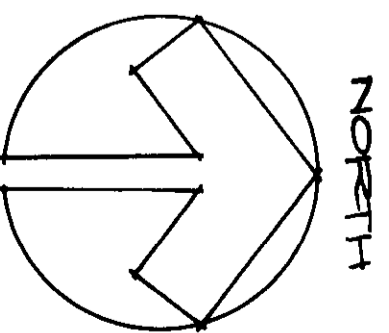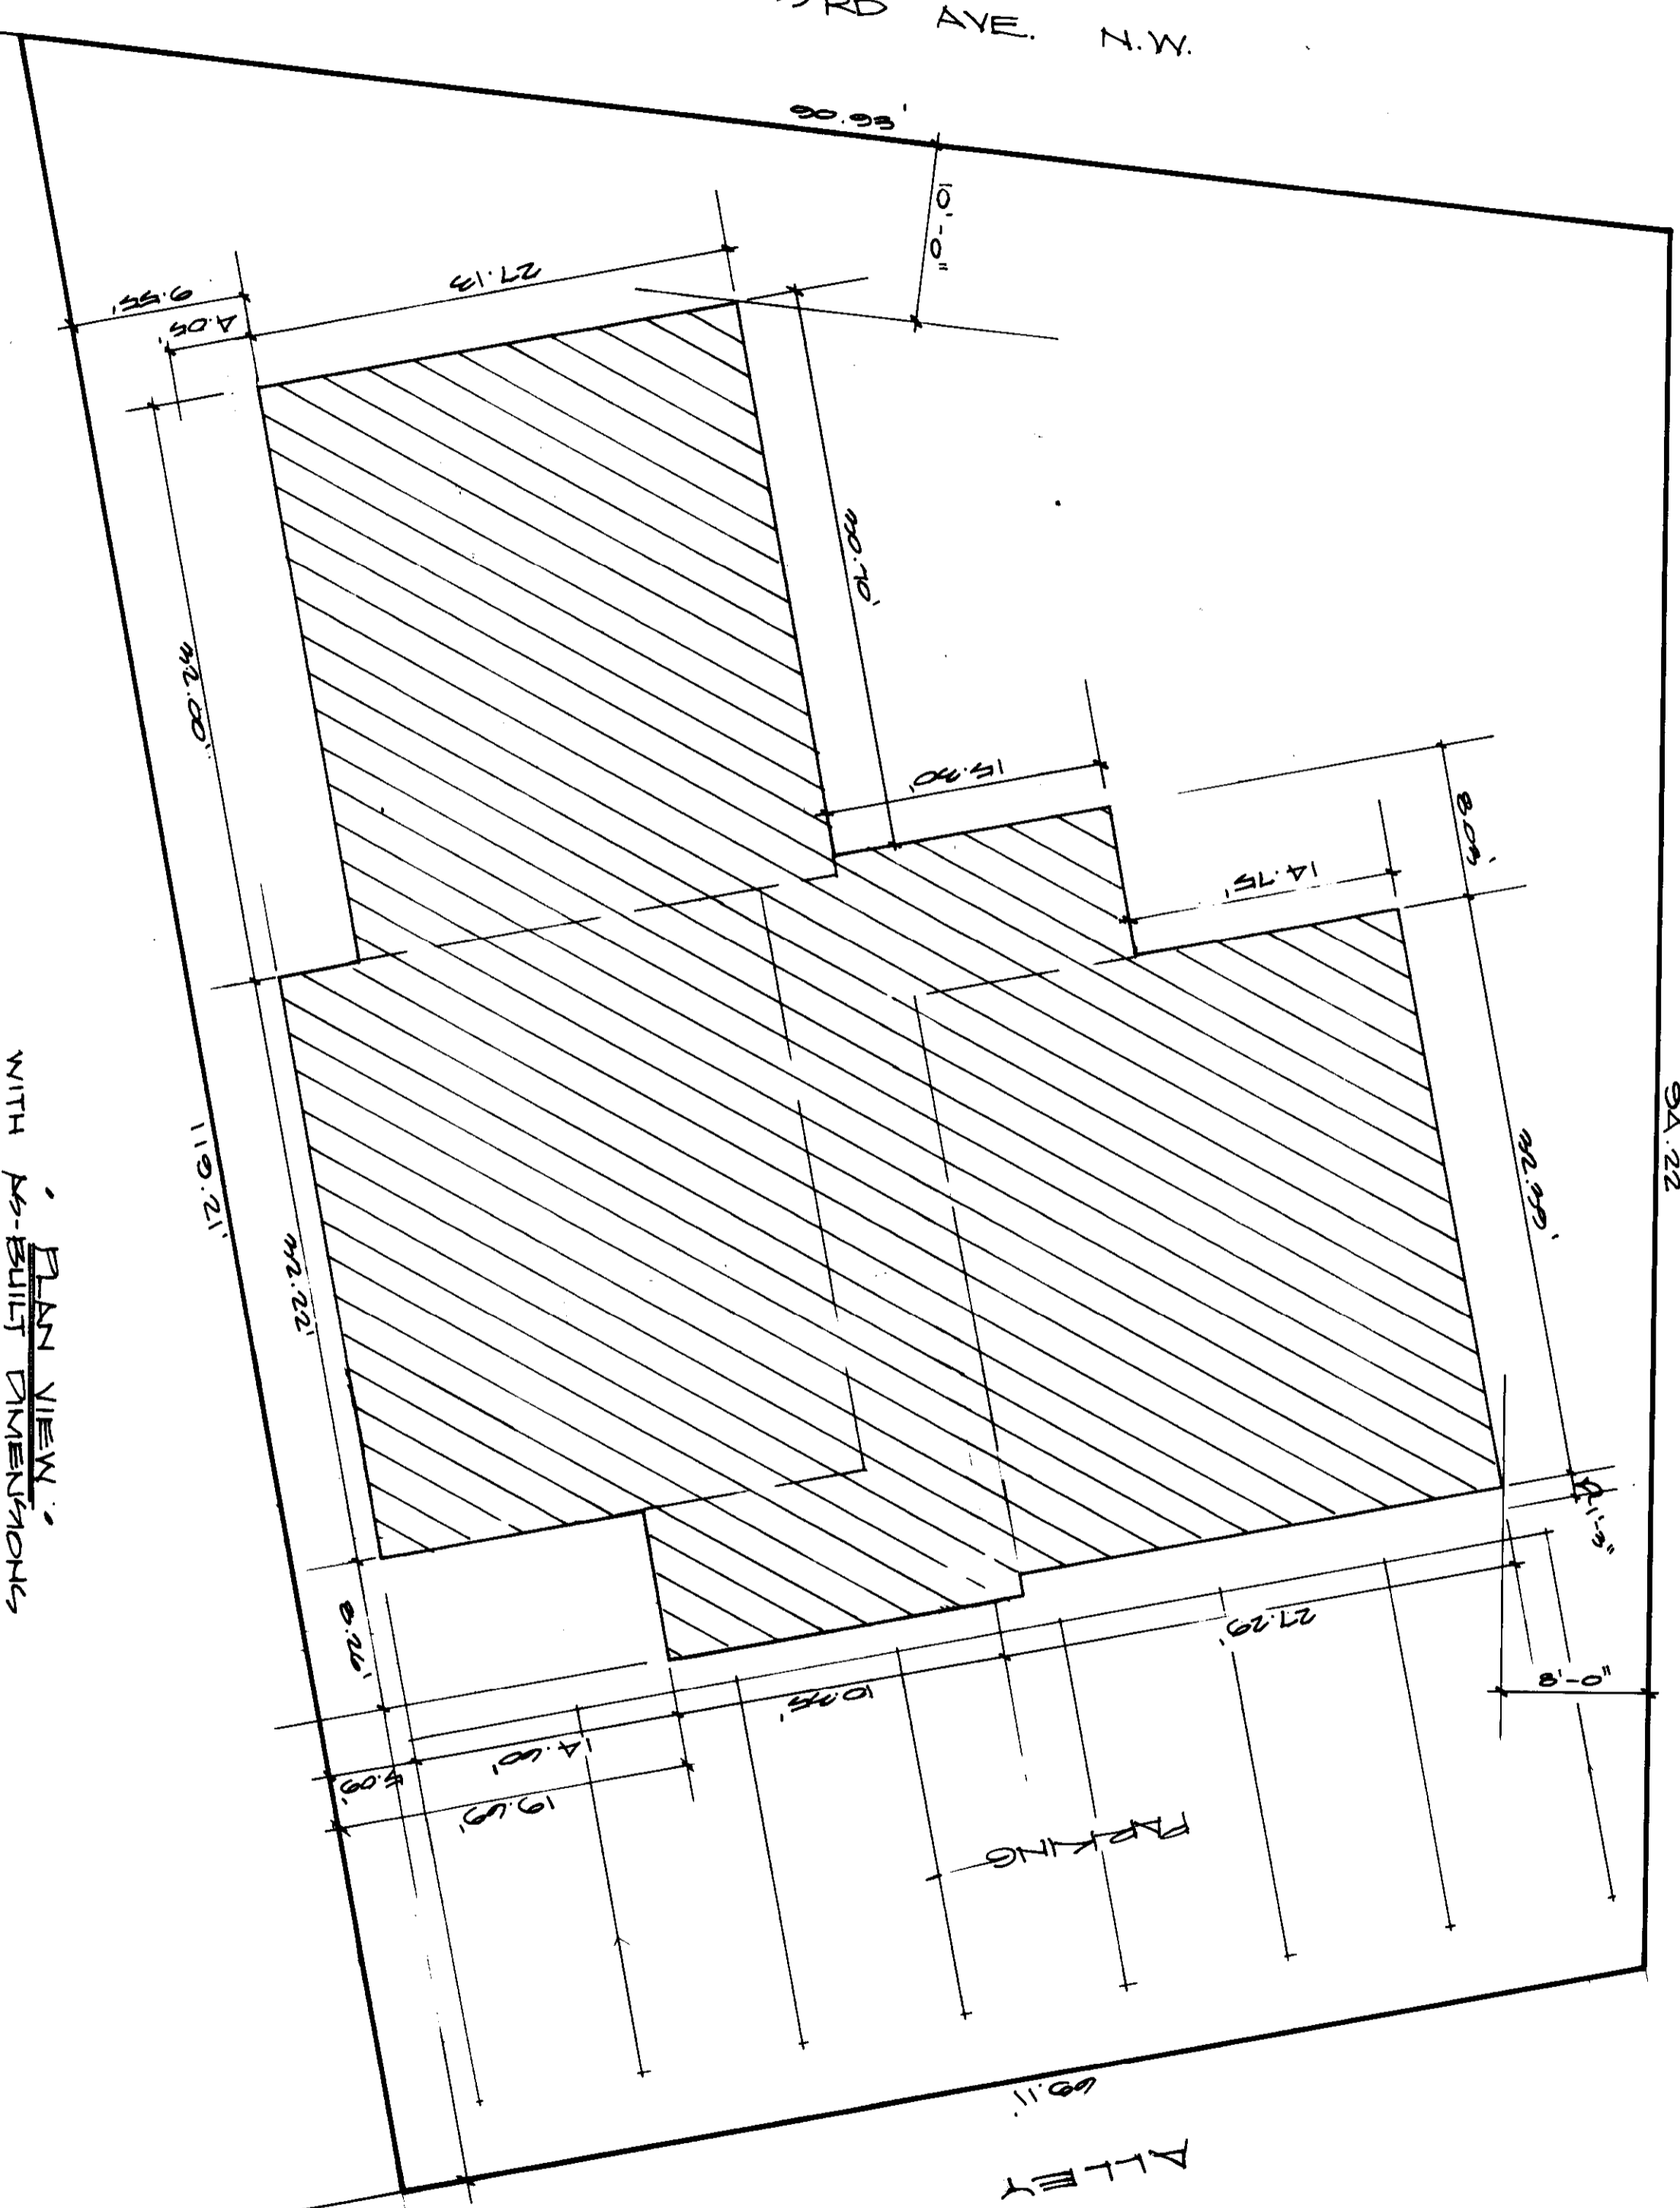

SCALE: 1/8" = 1'-0"

EASTSIDE CONSULTANTS

77181

11-2-77

SHEET 2 OF 5

14-37