



THE JUNIPER, A CONDOMINIUM

IN THE SE 1/4, NE 1/4 OF SECTION 20, T. 24 N., R. 42 E., W.M.

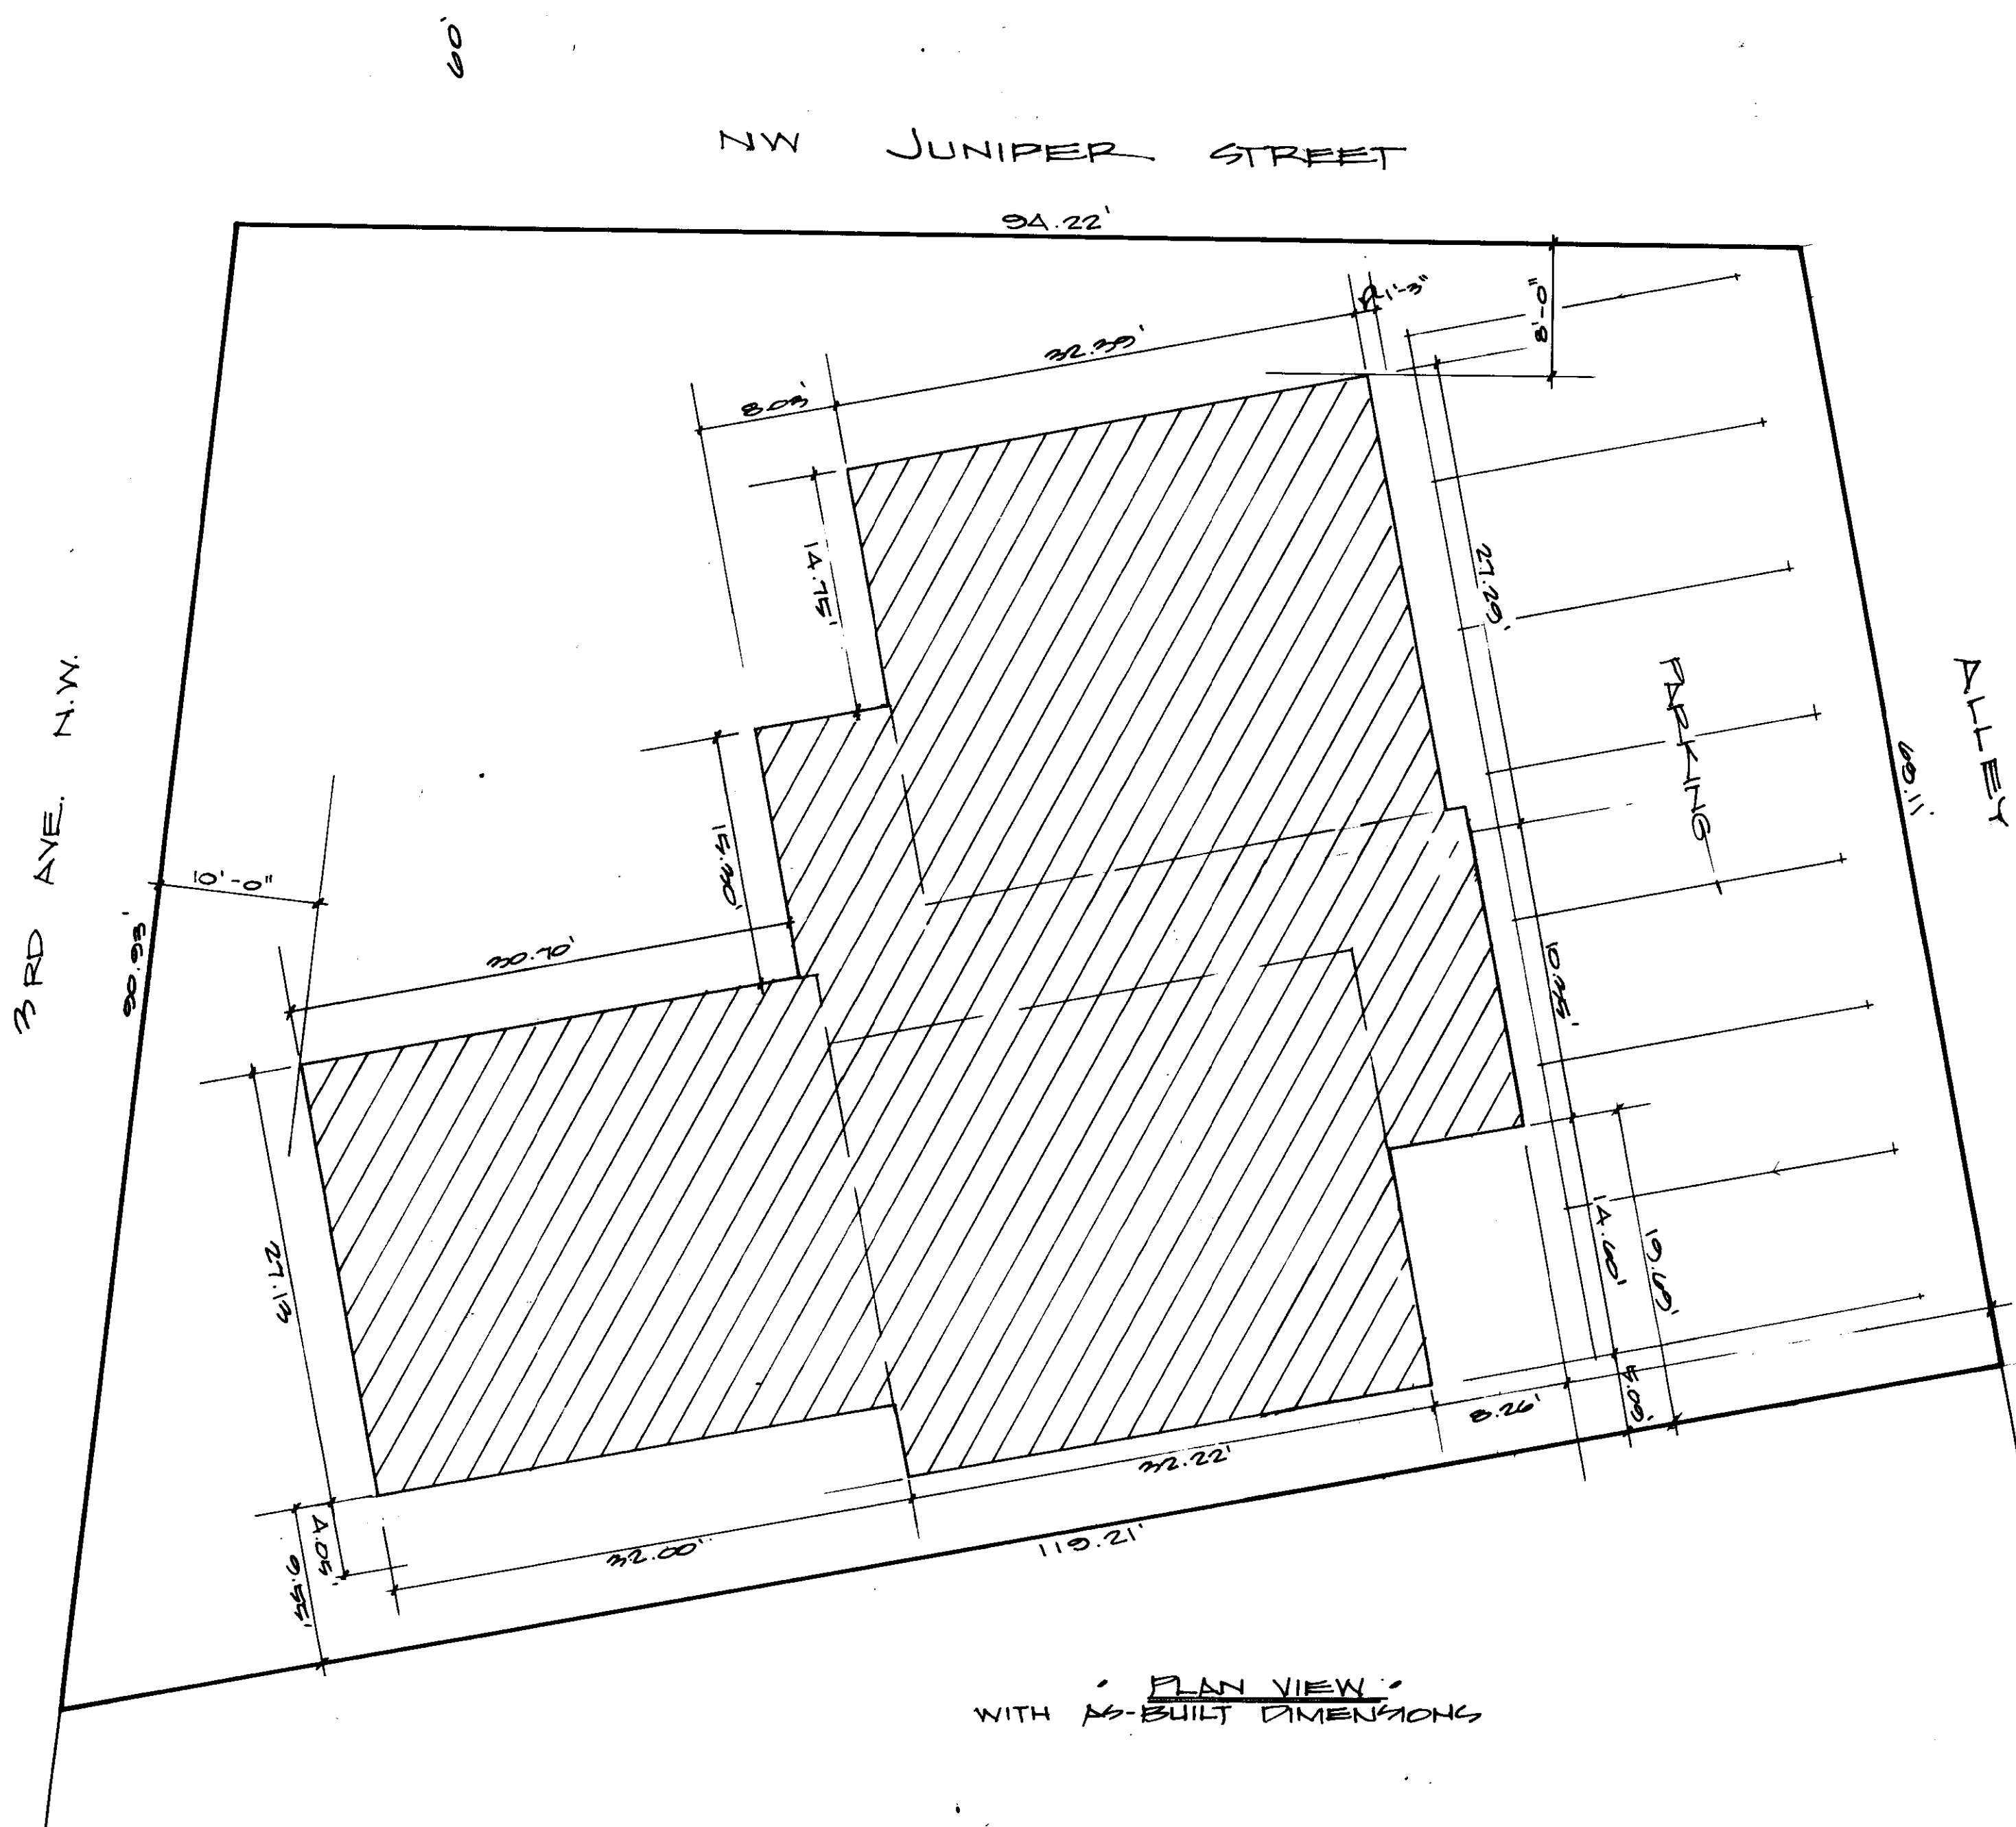


PLAN VIEW
WITH AS-BUILT DIMENSIONS

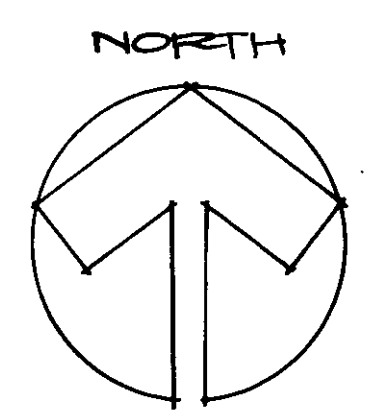

SCALE: 1/8" = 1'-0"
14-37



THE JUNIPER, A CONDOMINIUM

IN THE SE 1/4, NE 1/4 OF SECTION 20, T.24N, R.06E, W.M.

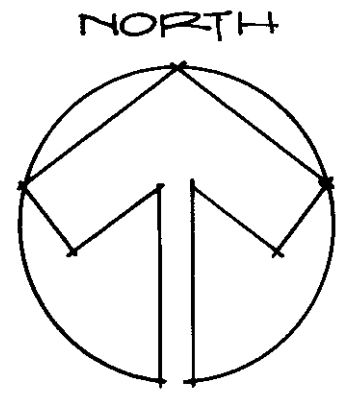

TYPICAL NOTES:



1. THE BOUNDARIES OF AN APARTMENT (TOWNHOUSE) ARE THE INTERIOR SURFACES OF THE WALLS, FLOORS, CEILING, WINDOWS AND DOORS, THEREOF, EXCLUDING ALL PIPES, DUCTS, WIRES, CONDUIT AND OTHER FACILITIES THAT RUN THROUGH ANY INTERIOR WALL OR PARTITION FOR THE PURPOSE OF FURNISHING UTILITY SERVICES TO SAID DWELLING.
2. THESE FLOOR PLANS AND THE DIMENSIONS HEREON ARE COMPILED FROM ARCHITECTURAL PLANS SUPPLEMENTED BY FIELD DATA. THE RESULTANT SAID DIMENSIONS, SHOWN HEREON, MAY THEREFORE VARY SLIGHTLY (WITHIN 01 OF A FOOT) WITH RESPECT TO THE ACTUAL DIMENSIONS.

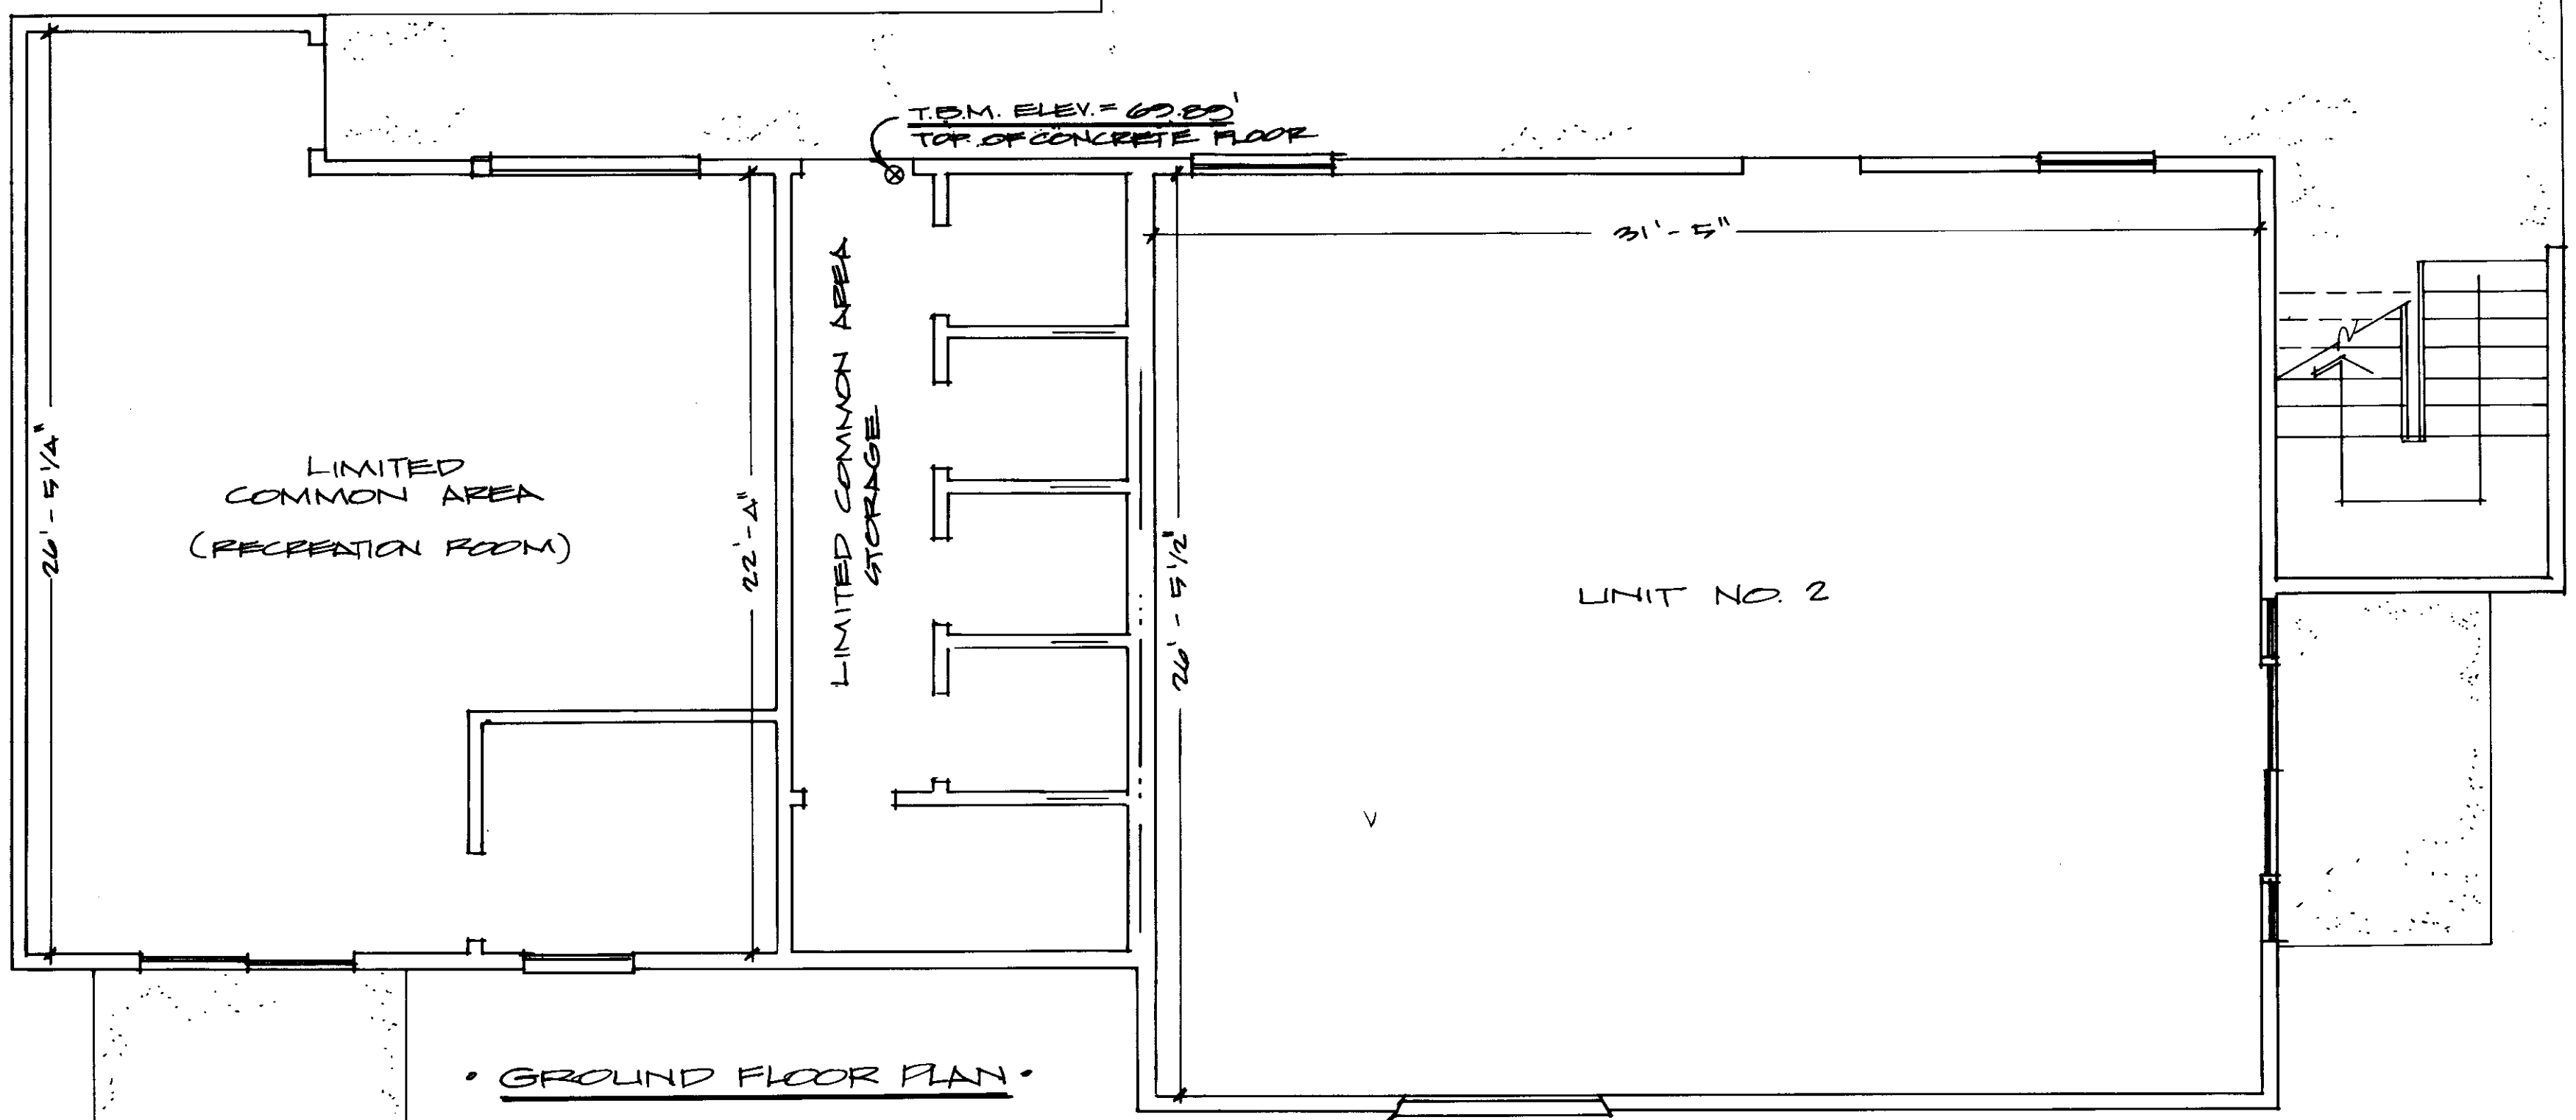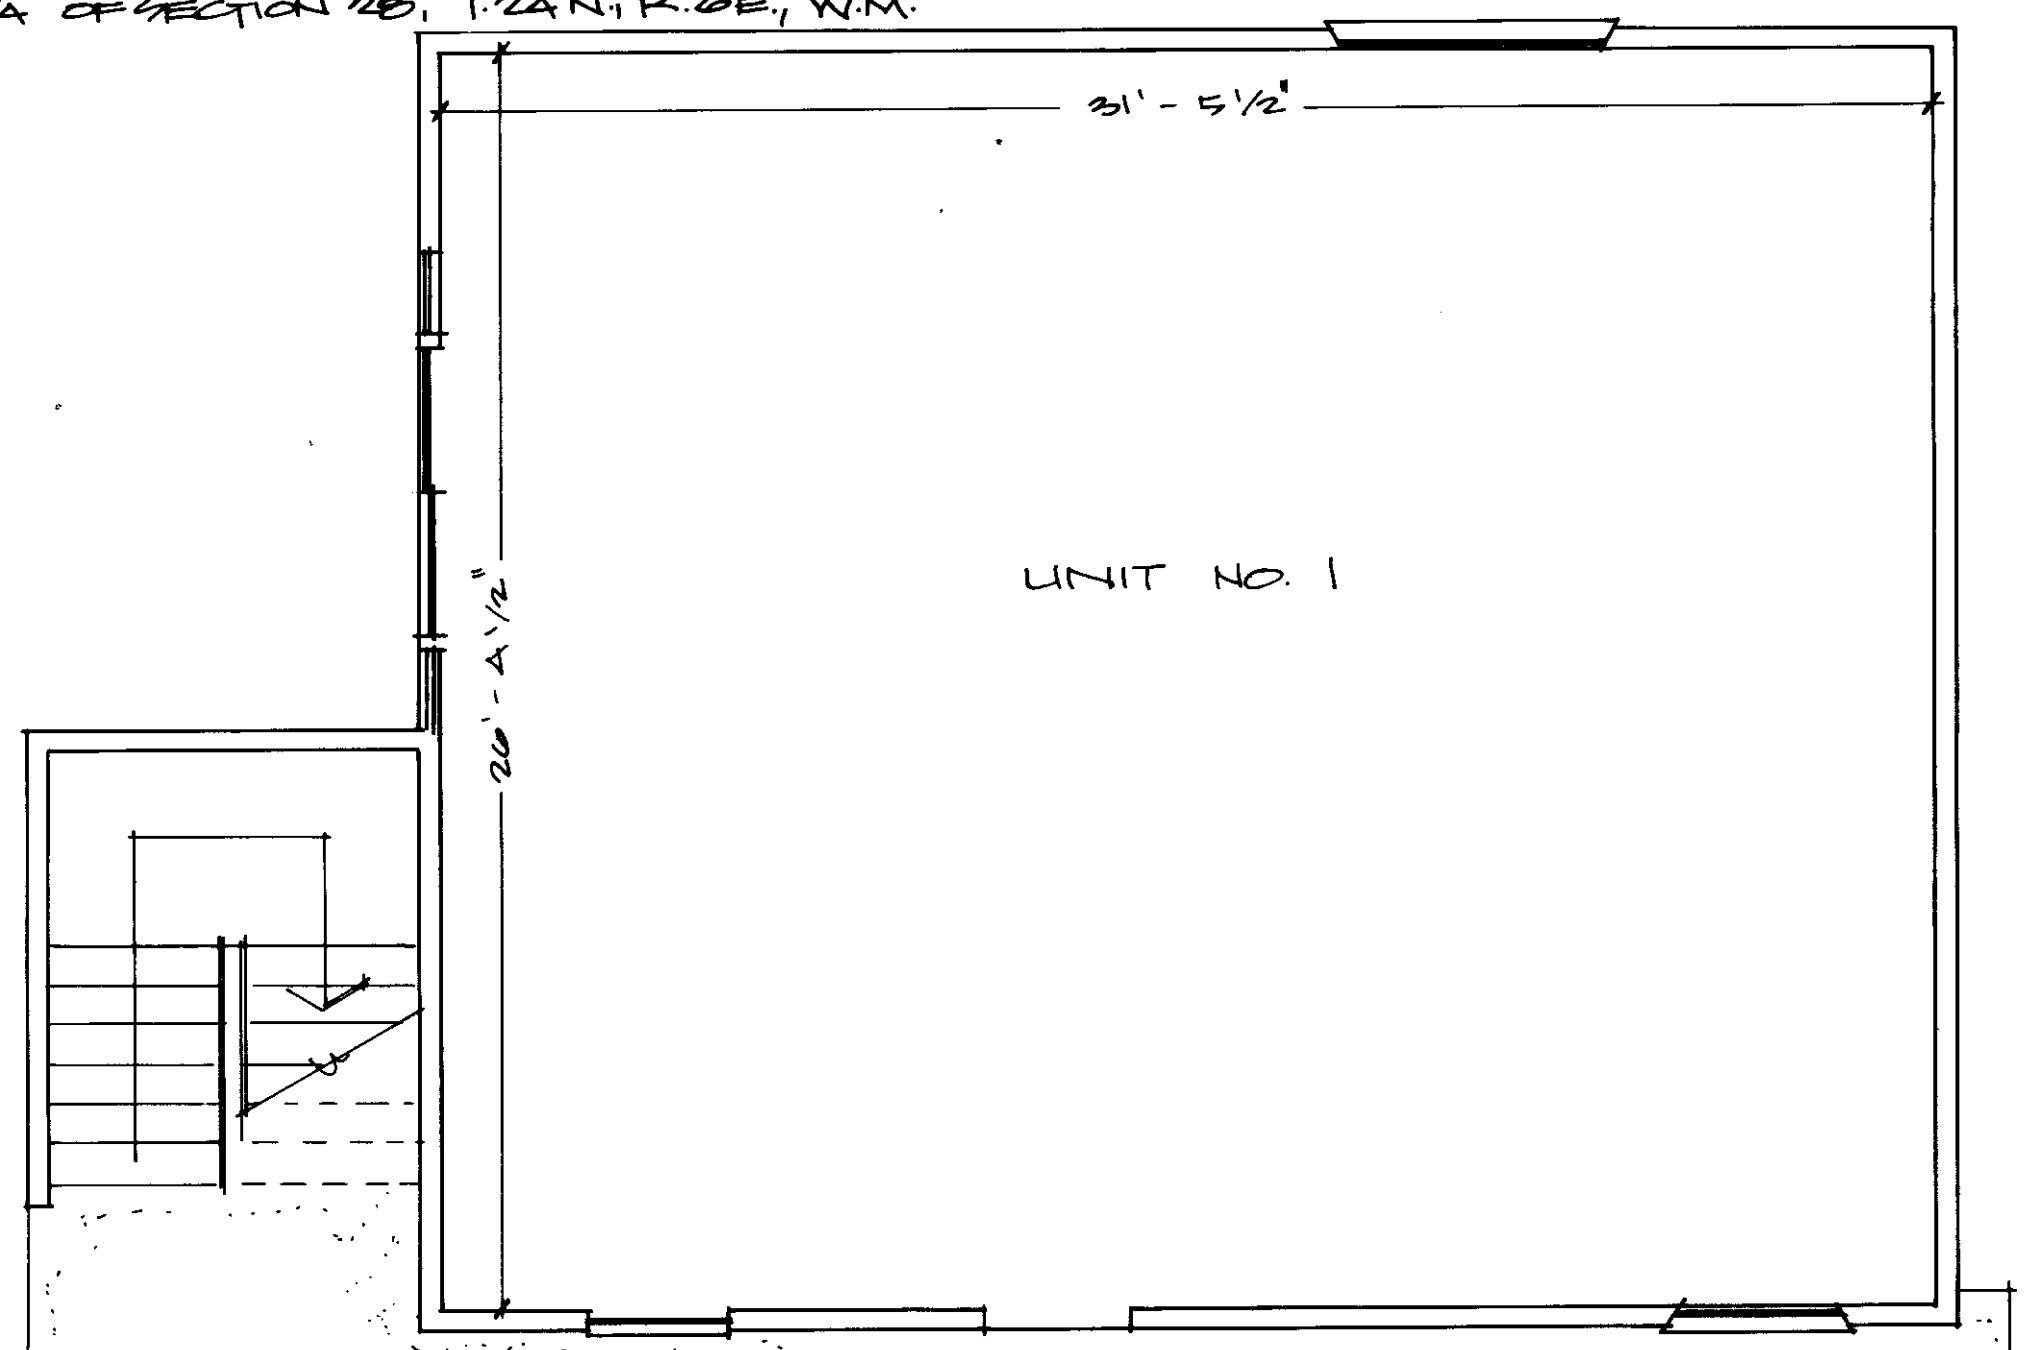

• GROUND FLOOR PLAN •

T.O.M. ELEV. = 60.80'
TOP OF CONCRETE FLOOR


THE JUNIPER, A CONDOMINIUM

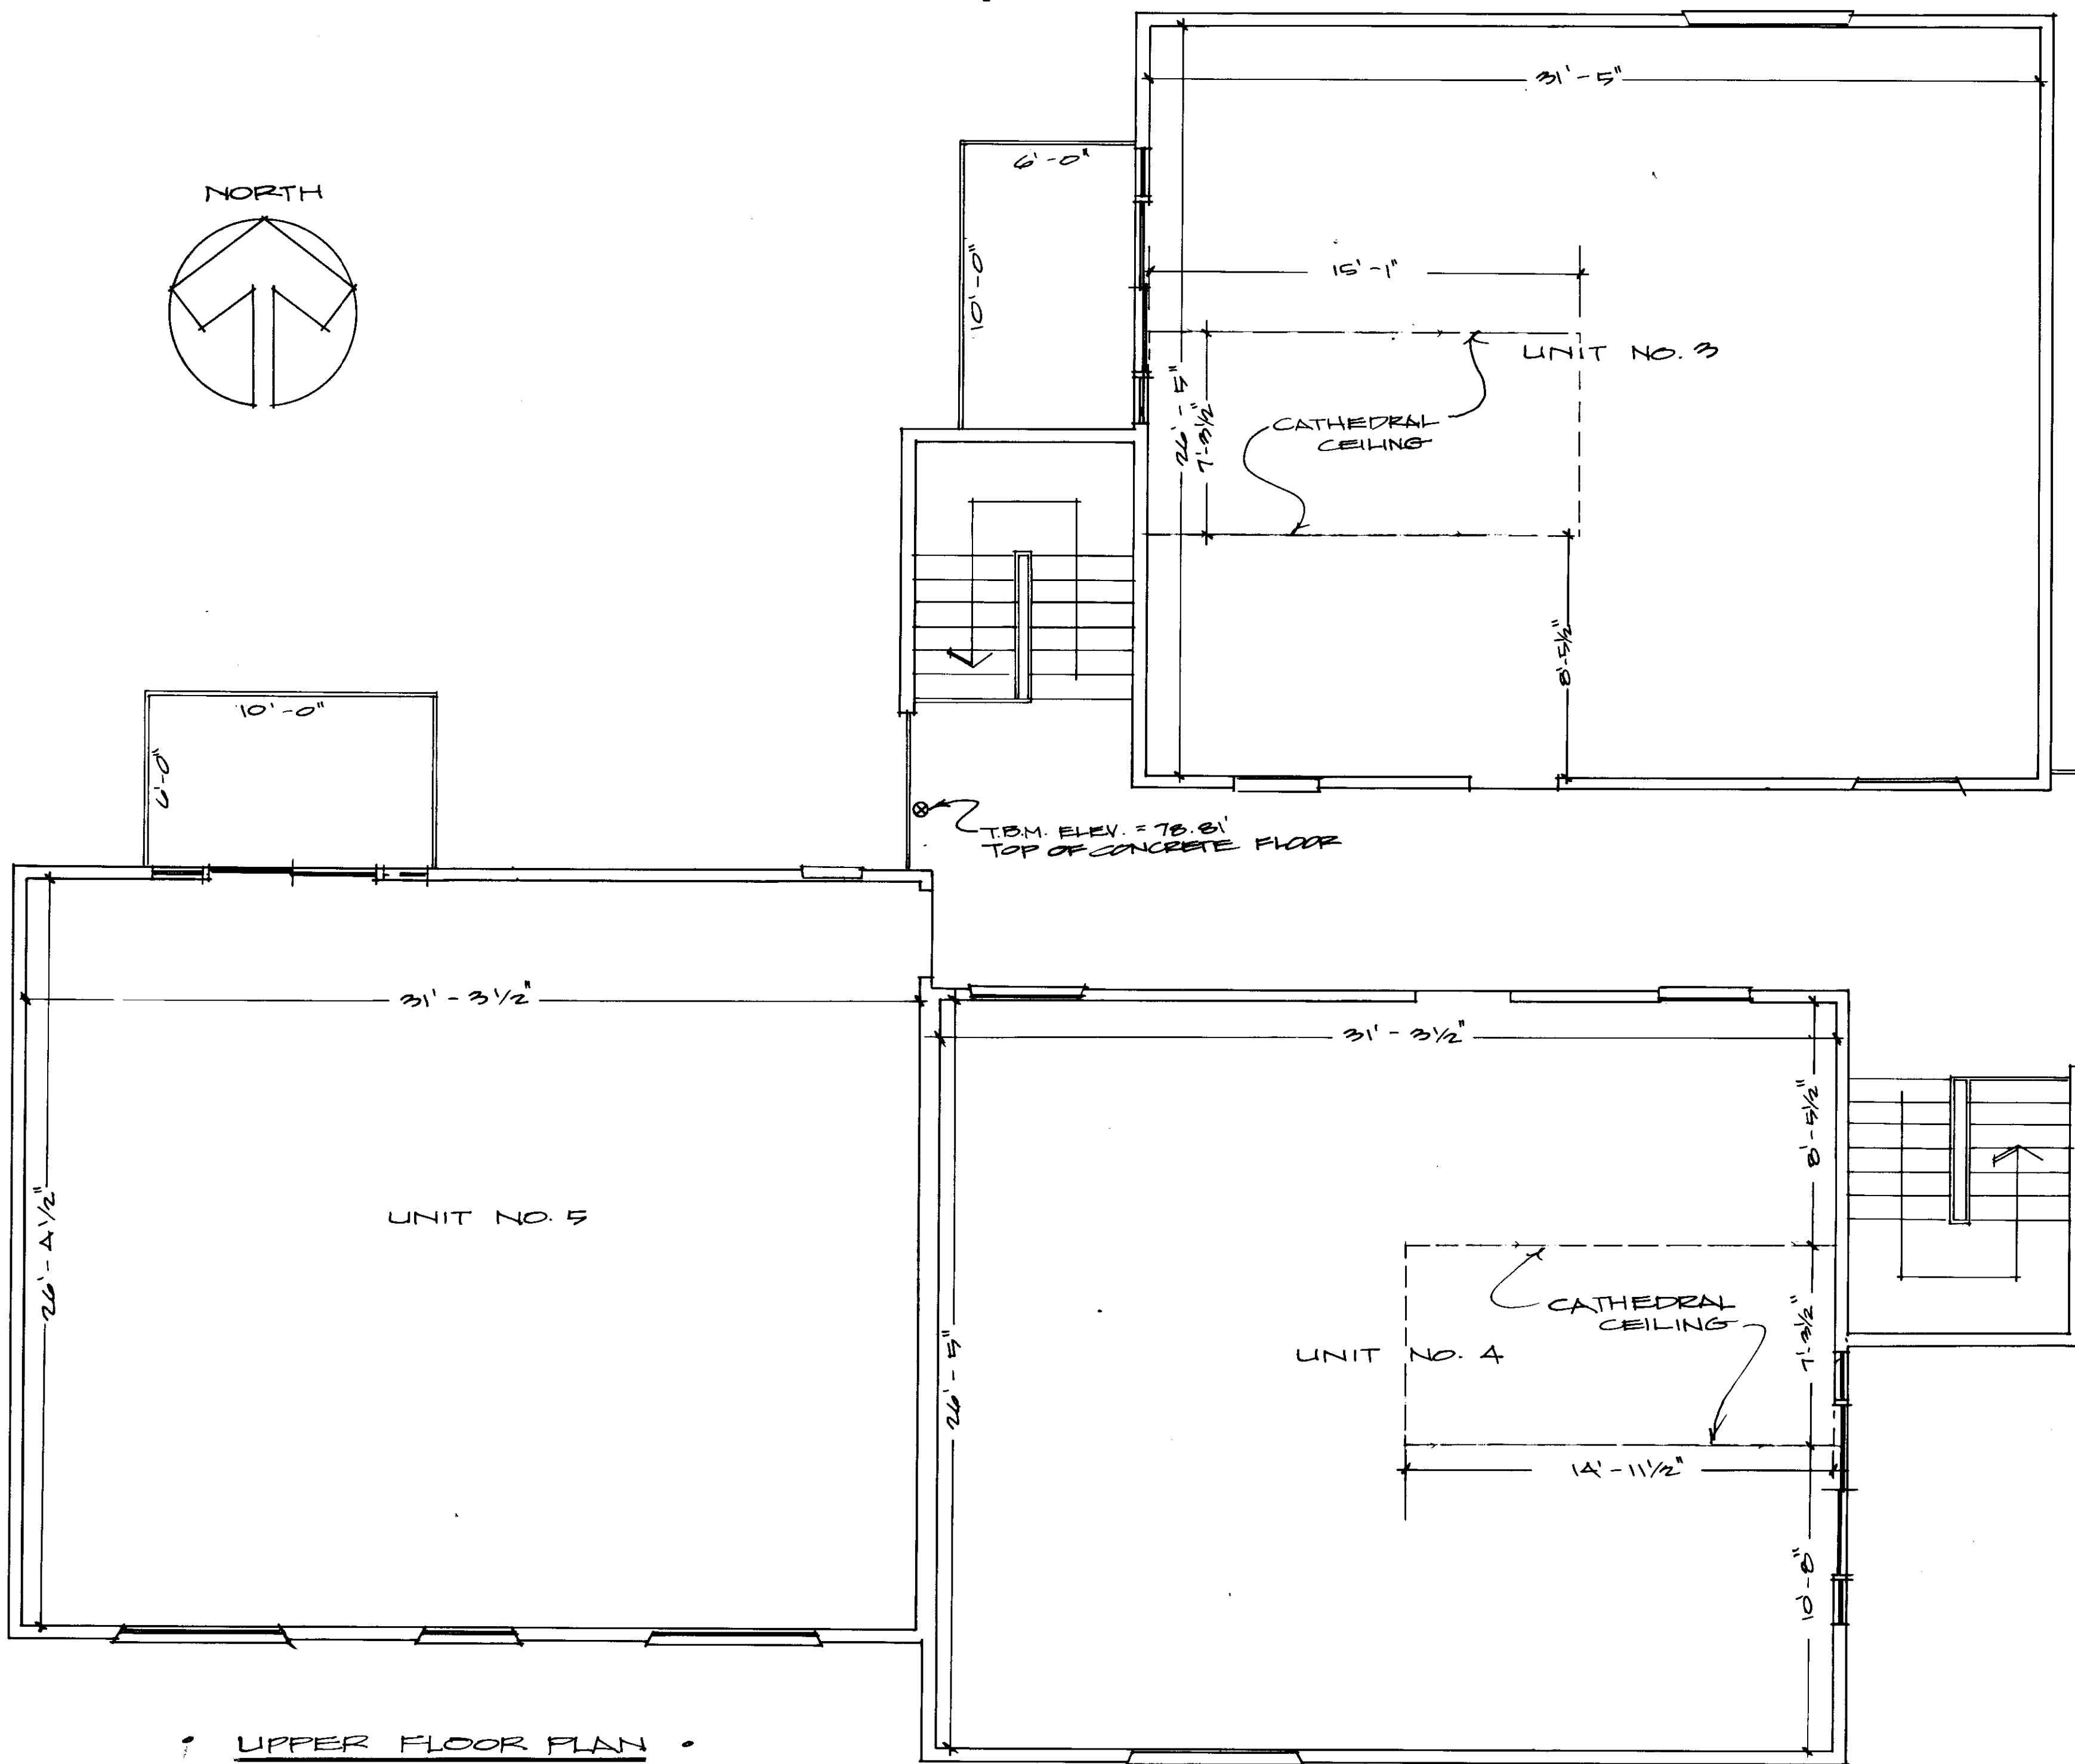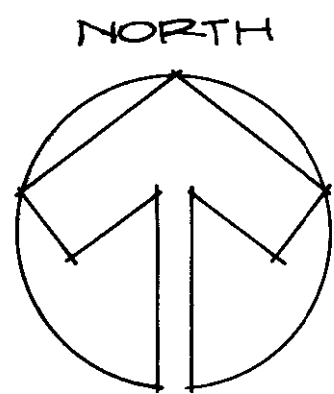

UPPER FLOOR PLAN

THE JUNIPER, A CONDOMINIUM

IN THE SE 1/4, NE 1/4 OF SECTION 28, T.24 N., R.6 E., W.M.

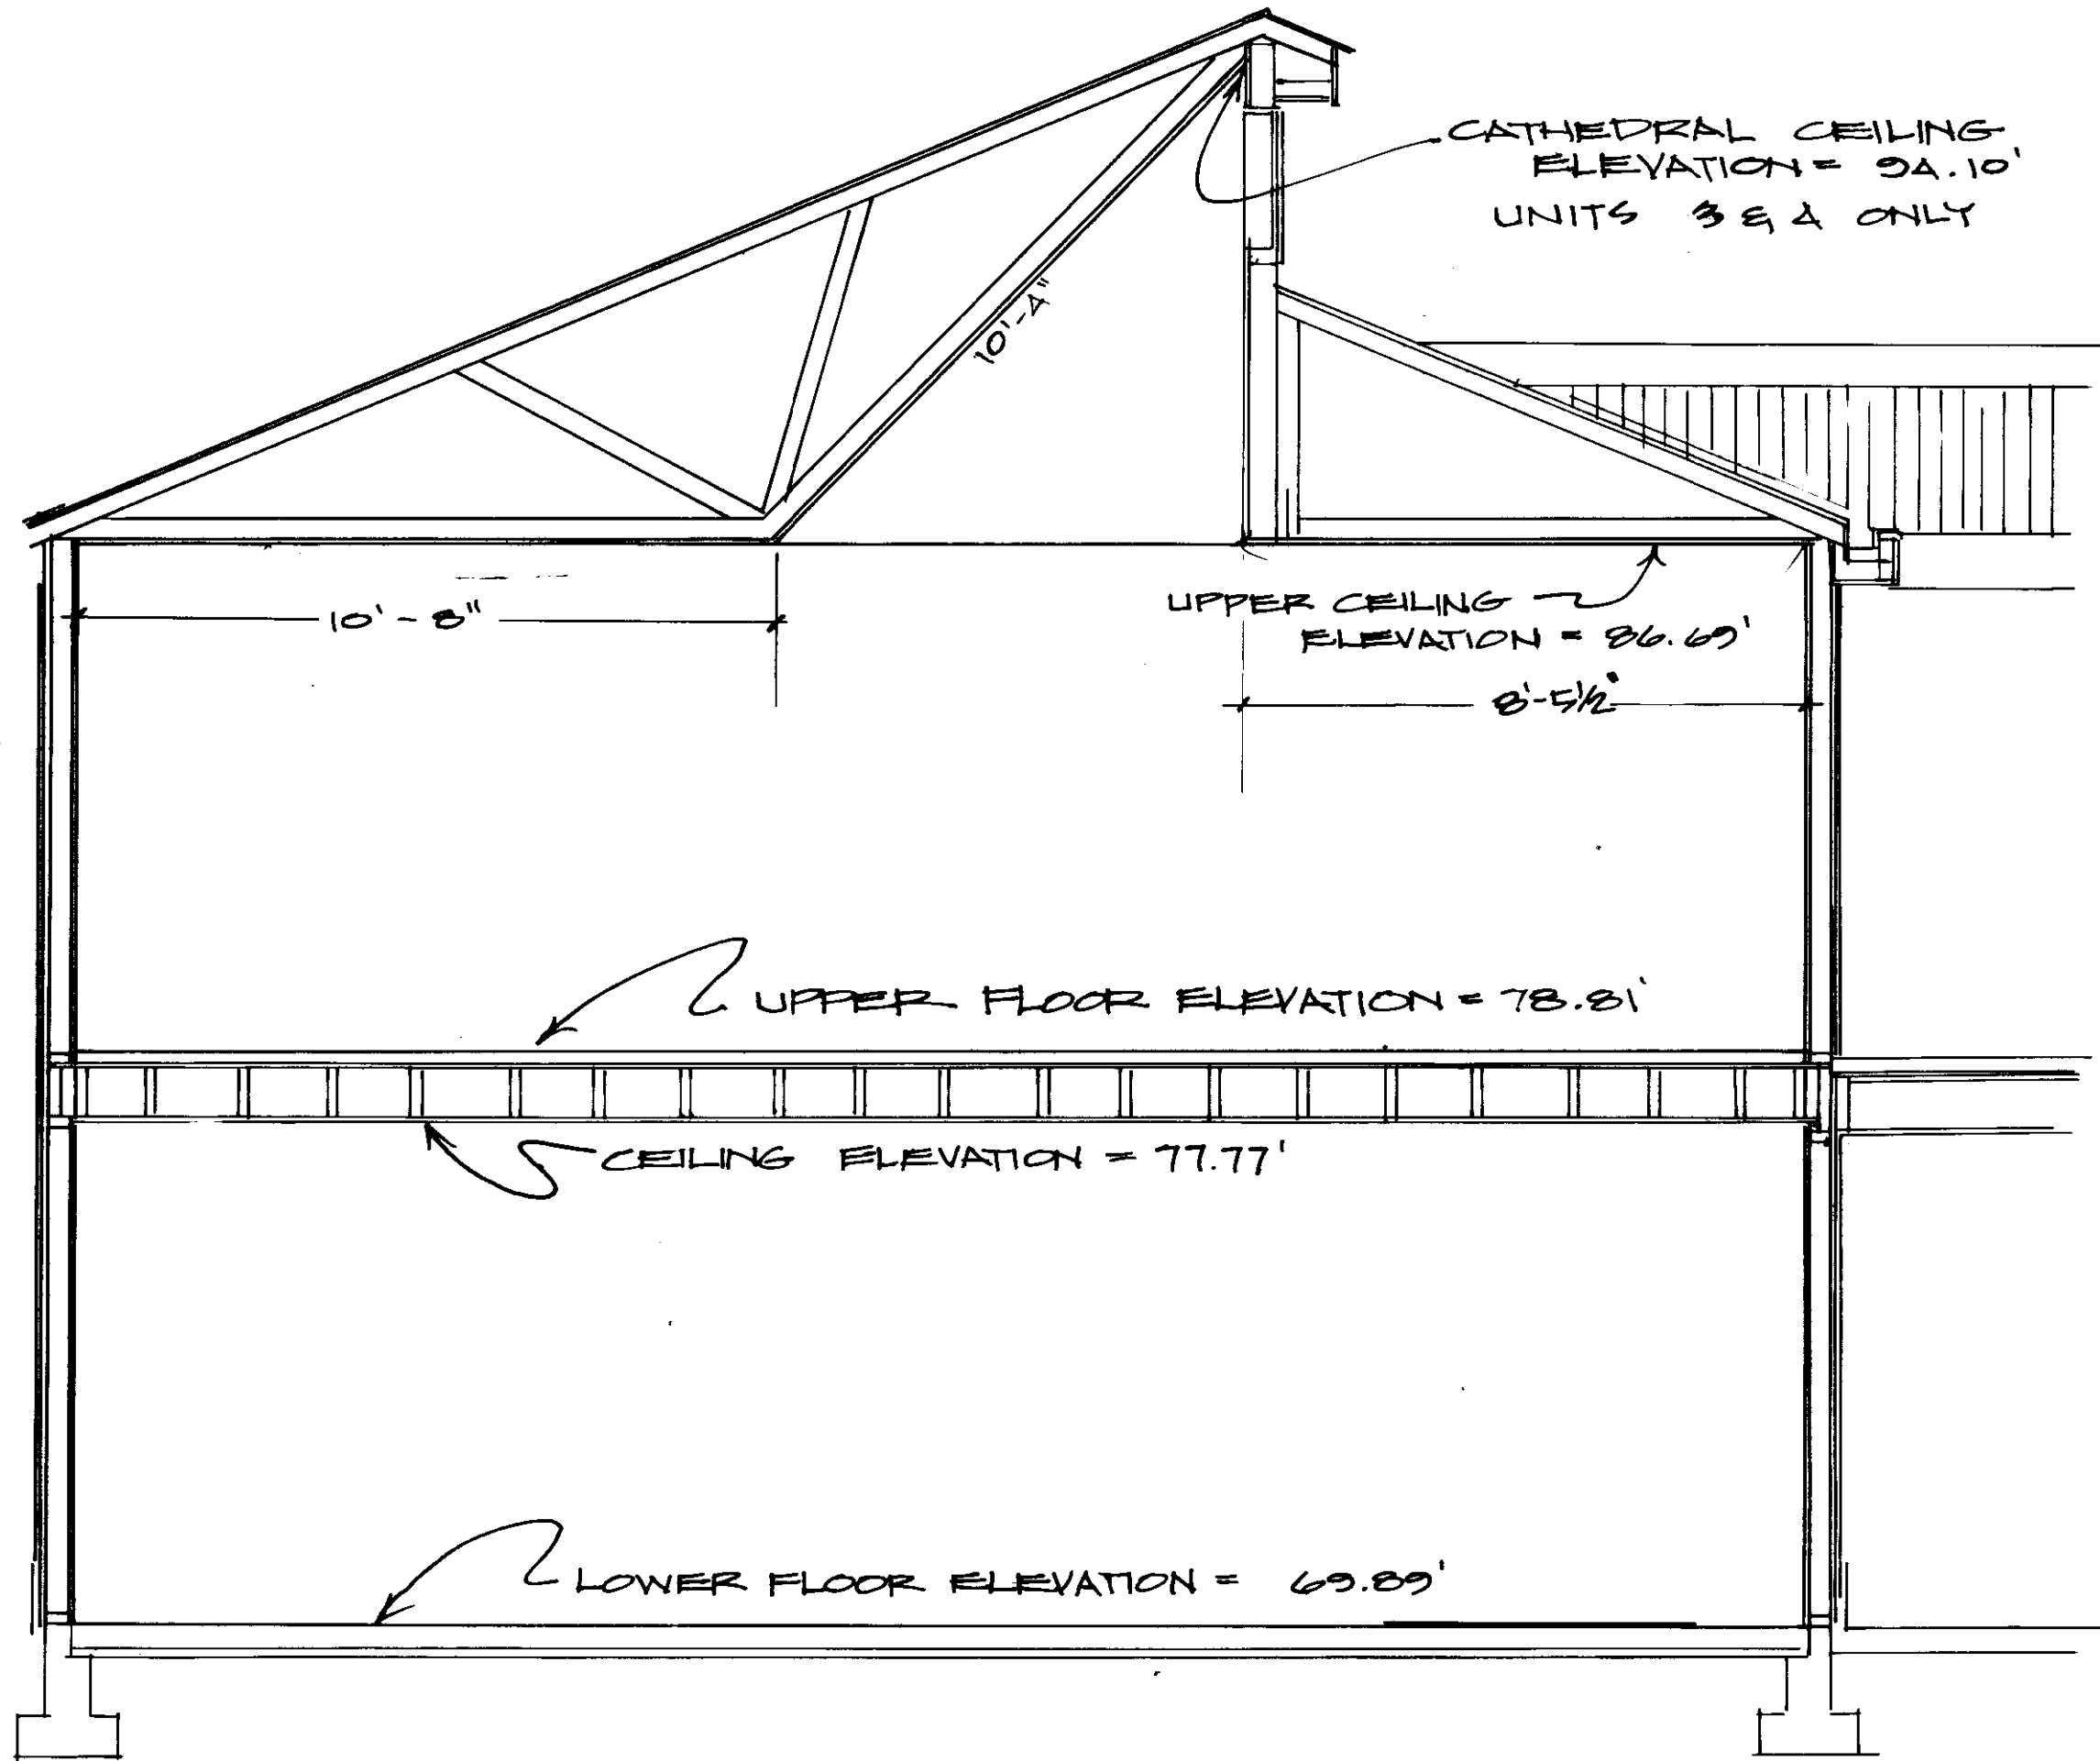

• TRAVERSE SECTION - TYPICAL •
WITH FLOOR AND CEILING ELEVATIONS
SCALE: 3/8" = 1'-0"